DIRECTION	MILEPOINT	LOCATION CODE (SHEET 2)	SIGN CODE	WIDTH (IN)	HEIGHT (IN)	SHEETING REMARKS	SIGN LEGEND	NEW SIGNS "A"	NEW SIGNS "B"	EXISTING SIGNS RETAIN	EXISTING SIGNS SALVAGE FROM	EXISTING SIGNS SALVAGE TO	EXISTING SIGNS REMOVE	EXIST POST RETAIN	EXIST POST REMOVE	NUMBER OF NEW POSTS	SQUARE STEEL (IN) 1.75 (LB / FT) 1.88	SQUARE STEEL (IN) 2.00 (LB / FT) 2.42	SQUARE STEEL (IN) 2.50 (LB / FT) 3.35	FOUNDATION	TUBULAR STEEL Ø (IN) 3.00 (LB / FT) 7.60	TUBULAR STEEL Ø (IN) 3.50 (LB / FT) 9.00	TUBULAR STEEL Ø (IN) 4.00 (LB / FT) 10.80	TUBULAR STEEL Ø (IN) 5.00 (LB / FT) 14.60	SIGN FRAME REQUIRED	REMARKS	SIGN DETAIL LOCATION SHSM	SIGN DETAIL LOCATION PROJECT SHEET #	SIGN DETAIL LOCATION STANDARD SHEET #
POULTNEY VT-31 NB							FY-FLUORESCENT YELLOW FYG-FLUORESCENT YELLOW GREEN																			"SHSM"-STANDARD HIGHWAY SIGNS AND MARKINGS			
NB	0.812	A	W1-2ML	30	30		MODIFIED LEFT CURVE						1		X											REMOVE ENTIRE SIGN ASSEMBLY.			
		A	W13-1	18	18		35 MPH ADVISORY						1																
		A	W1-10L	36	36	FY		9.00								2		15'-1" 15'-5" X								INSTALL 125 FEET NORTH OF EXISTING CURVE WARNING SIGN ASSEMBLY.	X		
		A	W13-1P	18	18	FY		2.25																			X		
NB	0.847	A	D3-1	UNK	UNK		RUBY RD STREET SIGN						1		X														
NB	0.848	C	VR-017	24	24								1	~~X~~	X											RUBY RD (TH-8)			
		C	VR-017	24	30			5.00								1		14'-4" X							~~INSTALL SIGN ON EXISTING FLANGED CHANNEL SIGN POST.~~		6	
NB	0.860	A	D3-1	32	12		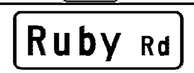	2.66																		RUBY RD (TH-8) INSTALL ABOVE STOP SIGN.		12	
		D	R1-1	30	30								1	~~X~~	X														
		D	R1-1	30	30			6.25								1		13'-6" X										
NB	0.878	A	W1-8L	18	24								1	X															
		A	W1-8L	18	24	FY		3.00																		INSTALL ON EXISTING FLANGED CHANNEL SIGN POST.	X		
NB	0.878	B	W1-8R	18	24								1	X															
		B	W1-8R	18	24	FY		3.00																		INSTALL ON EXISTING FLANGED CHANNEL SIGN POST.	X		
NB	0.902	A	W1-8L	18	24								1	X															
SIGN SUMMARY SHEET							SHEET TOTALS	31.16	0.00	0	0	0	8	0	0	~~4~~ 2			~~60.0~~ 30.0		0	0.0	0.0	0.0	0.0				
								SF	SF	EA	EA	EA	EA	EA	EA	EA			FT		EA	LB	LB	LB	LB				
VERMONT AGENCY OF TRANSPORTATION							TOWN DIRECTIONAL TOTALS	~~248.2~~ 243.2	0.0	2	0	0	~~60~~ 57	0	0	~~27~~ 25			~~405.0~~ 375.0		0	0.0							

PROJECT NAME: **STATEWIDE SOUTHWEST REGION**
PROJECT NUMBER: **STPG SIGN(41)**

FILE NAME: **12C118** PLOT DATE: **2/13/2013**
PROJECT MANAGER: **A. GAMBLE** DRAWN BY: **J. KELLY**
DESIGNED BY: **J. KELLY** CHECKED **A. GAMBLE**
POULTNEY NB SHEET 2 SHEET **65** OF **97**