DIRECTION	MILEPOINT	LOCATION CODE (SHEET 2)	SIGN CODE	WIDTH (IN)	HEIGHT (IN)	SHEETING REMARKS	SIGN LEGEND	NEW SIGNS "A"	NEW SIGNS "B"	EXISTING SIGNS RETAIN	EXISTING SIGNS SALVAGE FROM	EXISTING SIGNS SALVAGE TO	EXISTING SIGNS REMOVE	EXIST POST RETAIN	EXIST POST REMOVE	NUMBER OF NEW POSTS	SQUARE STEEL (IN) 1.75 (LB / FT) 1.88	SQUARE STEEL (IN) 2.00 (LB / FT) 2.42	SQUARE STEEL (IN) 2.50 (LB / FT) 3.35	FOUNDATION	TUBULAR STEEL Ø (IN) 3.00 (LB / FT) 7.60	TUBULAR STEEL Ø (IN) 3.50 (LB / FT) 9.00	TUBULAR STEEL Ø (IN) 4.00 (LB / FT) 10.80	TUBULAR STEEL Ø (IN) 5.00 (LB / FT) 14.60	SIGN FRAME REQUIRED	REMARKS	SIGN DETAIL LOCATION SHSM	SIGN DETAIL LOCATION PROJECT SHEET #	SIGN DETAIL LOCATION STANDARD SHEET #
POULTNEY VT-31 SB							FY-FLUORESCENT YELLOW FYG-FLUORESCENT YELLOW GREEN																			"SHSM"-STANDARD HIGHWAY SIGNS AND MARKINGS			
SB	3.202	E	VR-038	24	18								1	X															
		F	VR-041	24	24								1																
		F	R2-1	24	30								1																
		F	VR-039	24	18			3.00																		INSTALL NEW SIGNS ON EXISTING FLANGED CHANNEL SIGN POST.		6	
		F	R2-1	24	30			5.00																			X		
SB	3.037	F	W1-3R	30	30		RIGHT REVERSE CURVE						1		X														
		F	W13-1	18	18		35 MPH ADVISORY						1																
SB	2.965	F	W1-3R	30	30			6.25								1	17'-11" X									INSTALL 375 FEET SOUTH OF EXISTING RIGHT REVERSE CURVE SIGN ASSEMBLY.	X		
		F	W13-1P	18	18			2.25																			X		
SB	2.895	F	W1-8L	18	24		CHEVRON						1																
		E	W1-6R	48	24		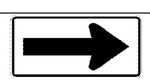	8.00								2	12'-6" 13'-6" X									X		
SB	2.888	F	W1-8L	18	24		CHEVRON						1		X														
		F	W1-6L	48	24		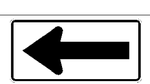	8.00								2	13'-8" 13'-10" X									X		
SB	2.881	F	W1-8L	18	24		CHEVRON						1		X														
SB	2.873	F	W1-8L	18	24		CHEVRON						1		X														
							SHEET TOTALS	32.50	0.00	0	0	0	9	0	0	5	75.0			0	0.0	0.0	0.0	0.0					
								SF	SF	EA	EA	EA	EA	EA	EA	EA	FT			EA	LB	LB	LB	LB					
							TOWN DIRECTIONAL TOTALS	207.2	0.0	2	0	0	43 ~~41~~	0	0	31 ~~29~~	465.0 ~~435.0~~			0	0.0								

SIGN SUMMARY SHEET

VERMONT AGENCY OF TRANSPORTATION

PROJECT NAME: STATEWIDE SOUTHWEST REGION
PROJECT NUMBER: STPG SIGN(41)

FILE NAME: 12C118
PROJECT MANAGER: A. GAMBLE
DESIGNED BY: J. KELLY
POULTNEY SB SHEET 2

PLOT DATE: 2/13/2013
DRAWN BY: J. KELLY
CHECKED A. GAMBLE