DIRECTION	MILEPOINT	LOCATION CODE (SHEET 2)	SIGN CODE	WIDTH (IN)	HEIGHT (IN)	SHEETING REMARKS	SIGN LEGEND	NEW SIGNS "A"	NEW SIGNS "B"	EXISTING SIGNS RETAIN	EXISTING SIGNS SALVAGE FROM	EXISTING SIGNS SALVAGE TO	EXISTING SIGNS REMOVE	EXIST POST RETAIN	EXIST POST REMOVE	NUMBER OF NEW POSTS	SQUARE STEEL (IN) 1.75 (LB / FT) 1.88	SQUARE STEEL (IN) 2.00 (LB / FT) 2.42	SQUARE STEEL (IN) 2.50 (LB / FT) 3.35	FOUNDATION	TUBULAR STEEL Ø (IN) 3.00 (LB / FT) 7.60	TUBULAR STEEL Ø (IN) 3.50 (LB / FT) 9.00	TUBULAR STEEL Ø (IN) 4.00 (LB / FT) 10.80	TUBULAR STEEL Ø (IN) 5.00 (LB / FT) 14.60	SIGN FRAME REQUIRED	REMARKS	SIGN DETAIL LOCATION SHSM	SIGN DETAIL LOCATION PROJECT SHEET #	SIGN DETAIL LOCATION STANDARD SHEET #
POWNAL VT-346 SB							FY-FLUORESCENT YELLOW FYG-FLUORESCENT YELLOW GREEN																			"SHSM"-STANDARD HIGHWAY SIGNS AND MARKINGS			
		E	W1-6	48	24								1																
		F	W1-6R	48	24			8.00								2		13'-6" 15'-0" X								INSTALL BACK TO BACK ON NEW POSTS.	X		
		E	W1-6L	48	24			8.00																			X		
SB	3.800	F F	VD-700 VR-654	6 24	10 24		DON'T DRIVE AND DRIVE 3460 0208 0380			~~1~~	1	1	1	X												CUT OFF POST JUST ABOVE THE 3.80 MILE MARKER SIGN.			
		F	VR-655	24	18		STRICTLY ENFORCED			~~1~~			1																
SB	3.744	F	VD-018	30	18								1	X															
		F	VD-018	30	18		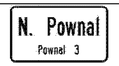	3.75																	INSTALL ON EXISTING FLANGED CHANCEL SIGN POST.		5	
SB	3.695	F	R2-1	24	30								1	X															
		F	R2-1	24	30			5.00																	INSTALL ON EXISTING FLANGED CHANCEL SIGN POST.	X		
SB	3.644	F	W1-1MR	30	30		MODIFIED RIGHT TURN						1		X														
		F	W13-1	18	18		25 MPH ADVISORY						1																
SB	3.614	F F	VD-700 VW-054R	6 30	10 30		HIDDEN DRIVE RIGHT 3460 0208 0360				1		1		X														
		F F	VD-700 VW1-1RML	6 36	10 36			9.00				1				2		15'-0" 15'-0" X										7	
		F	W13-1P	18	18			2.25																			X		
SB	3.589	F	D1-1A	72	10								1	X															
SIGN SUMMARY SHEET							SHEET TOTALS	36.00	0.00	~~2~~ 0	~~0~~ 2	~~0~~ 2	~~7~~ 9	0	0	4		60.0		0	0.0	0.0	0.0	0.0					
								SF	SF	EA	EA	EA	EA	EA	EA	EA		FT		EA	LB	LB	LB	LB					
VERMONT AGENCY OF TRANSPORTATION							TOWN DIRECTIONAL TOTALS	~~339.8~~ 346.1	0.0	~~32~~ 33	~~0~~ 5	~~0~~ 5	~~66~~ 72	0	0	~~28~~ 30		~~420.0~~ 450.0		0	0.0								

PROJECT NAME: STATEWIDE SOUTHWEST REGION
PROJECT NUMBER: STPG SIGN(41)

FILE NAME: 12C118
PROJECT MANAGER: A. GAMBLE
DESIGNED BY: J. KELLY
POWNAL SB SHEET 3

PLOT DATE: 2/13/2013
DRAWN BY: J. KELLY
CHECKED: A. GAMBLE