this will conflict with installation of the approach slabs. suggest moving it outward 6". (typ)

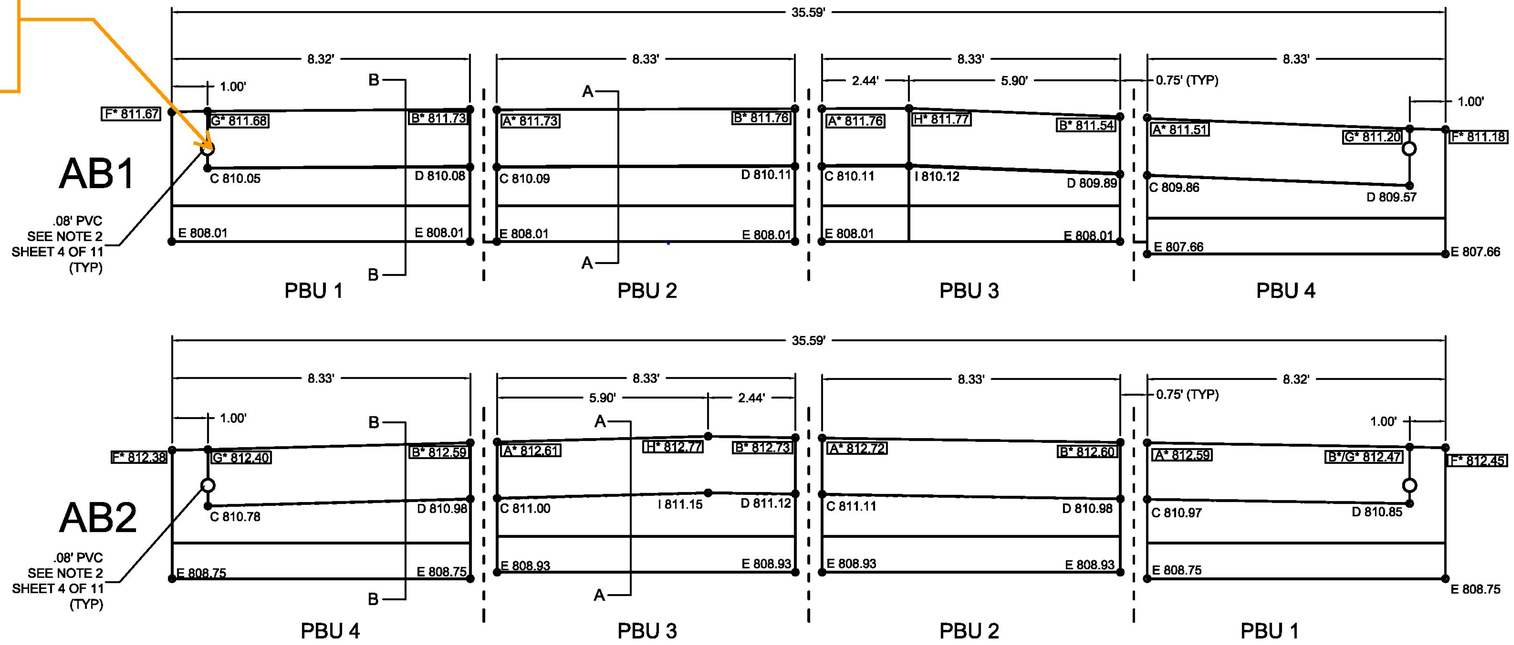

NOTE:

1. ELEVATIONS IN BOX SHALL BE MODIFIED TO MATCH THE ELEVATIONS AND SLOPE PROJECTIONS OF THE PRECAST DECK.
2. DRILL .16' DIA HOLE WITH .50' EMBEDMENT
3. GROUT USING (SPEC CHEM SC MULTIPURPOSE GROUT)
4. ~~ALL DIMENSIONS ARE ALONG ABUTMENT BEARING LINE~~
   ALL HORIZONTAL DIMENSIONS ARE PERPENDICULAR TO CENTERLINE GIRDER; ADJUST BY SKEW ANGLE FOR DIMENSIONS ALONG CENTERLINE BEARING AT ABUTMENTS

CURTAIN WALL DETAILS BHF 0169 (09)

NOT TO SCALE

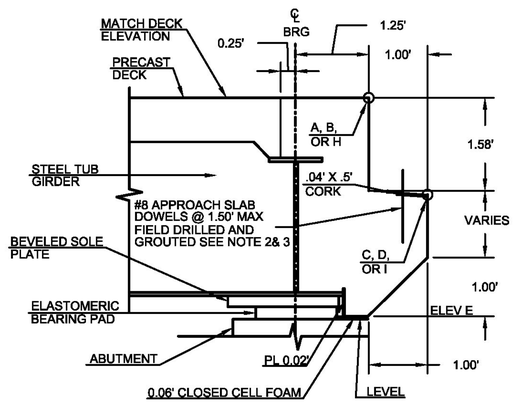

SECTION A-A
N.T.S.
(NORMAL TO CL BRG)

Vermont Agency of Transportation
RECEIVED
CK'D BY TYLin OK'D BY TYlin
April 5, 2017
RESUBMIT No Approved AsNoted
BY Kristin Higgins DATE 4/7/2017

T.Y. LIN INTERNATIONAL
THE STAMPED DOCUMENTS ARE HEREBY:
___ APPROVED
_X_ APPROVED AS NOTED
___ REVISE AND RESUBMIT
SEE TRANSMITTAL FOR ADDITIONAL INFORMATION AS APPLICABLE.
THIS REVIEW IS FOR GENERAL CONFORMANCE WITH DESIGN CONCEPT ONLY. ANY DEVIATION FROM THE PLANS OR SPECIFICATIONS NOT CLEARLY NOTED BY THE CONTRACTOR HAS NOT BEEN REVIEWED. REVIEW BY THE ENGINEER SHALL NOT RELIEVE THE CONTRACTOR OF THE CONTRACTUAL RESPONSIBILITY FOR ANY ERRORS OR DEVIATION FROM THE CONTRACT REQUIREMENTS.
JOSH OLUND REVIEWER
April 5, 2017 DATE

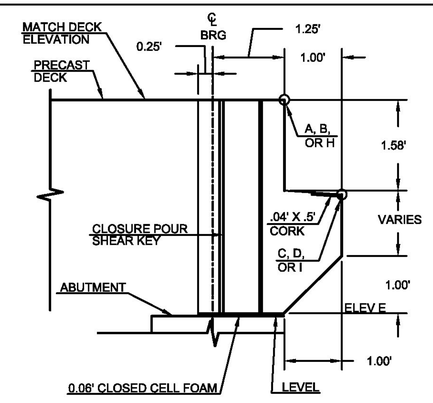

SECTION B-B
N.T.S.
(NORMAL TO CL BRG)
(THROUGH CLOSURE POUR)

CPM CONSTRUCTORS
80 MARKET STREET
P.O. BOX 10
FARMINGTON, MAINE 04938-0000
(207)865-3000 FAX (207) 865-4836

PROJECT INFORMATION
DESIGNED:
DRAWN: TROY CHESSMAN
CHECKED: JAMES HALL
P.E. NUMBER:
APPROVED BY: KENT GERRISH
SUBMITTED: SEPT-1 09/06/2017
DATE:
REVISED: NOT TO SCALE

CURTAIN WALL DETAILS
BHF 0169(09)
CHELSEA, VERMONT

SHEET NUMBER
7
OF 11