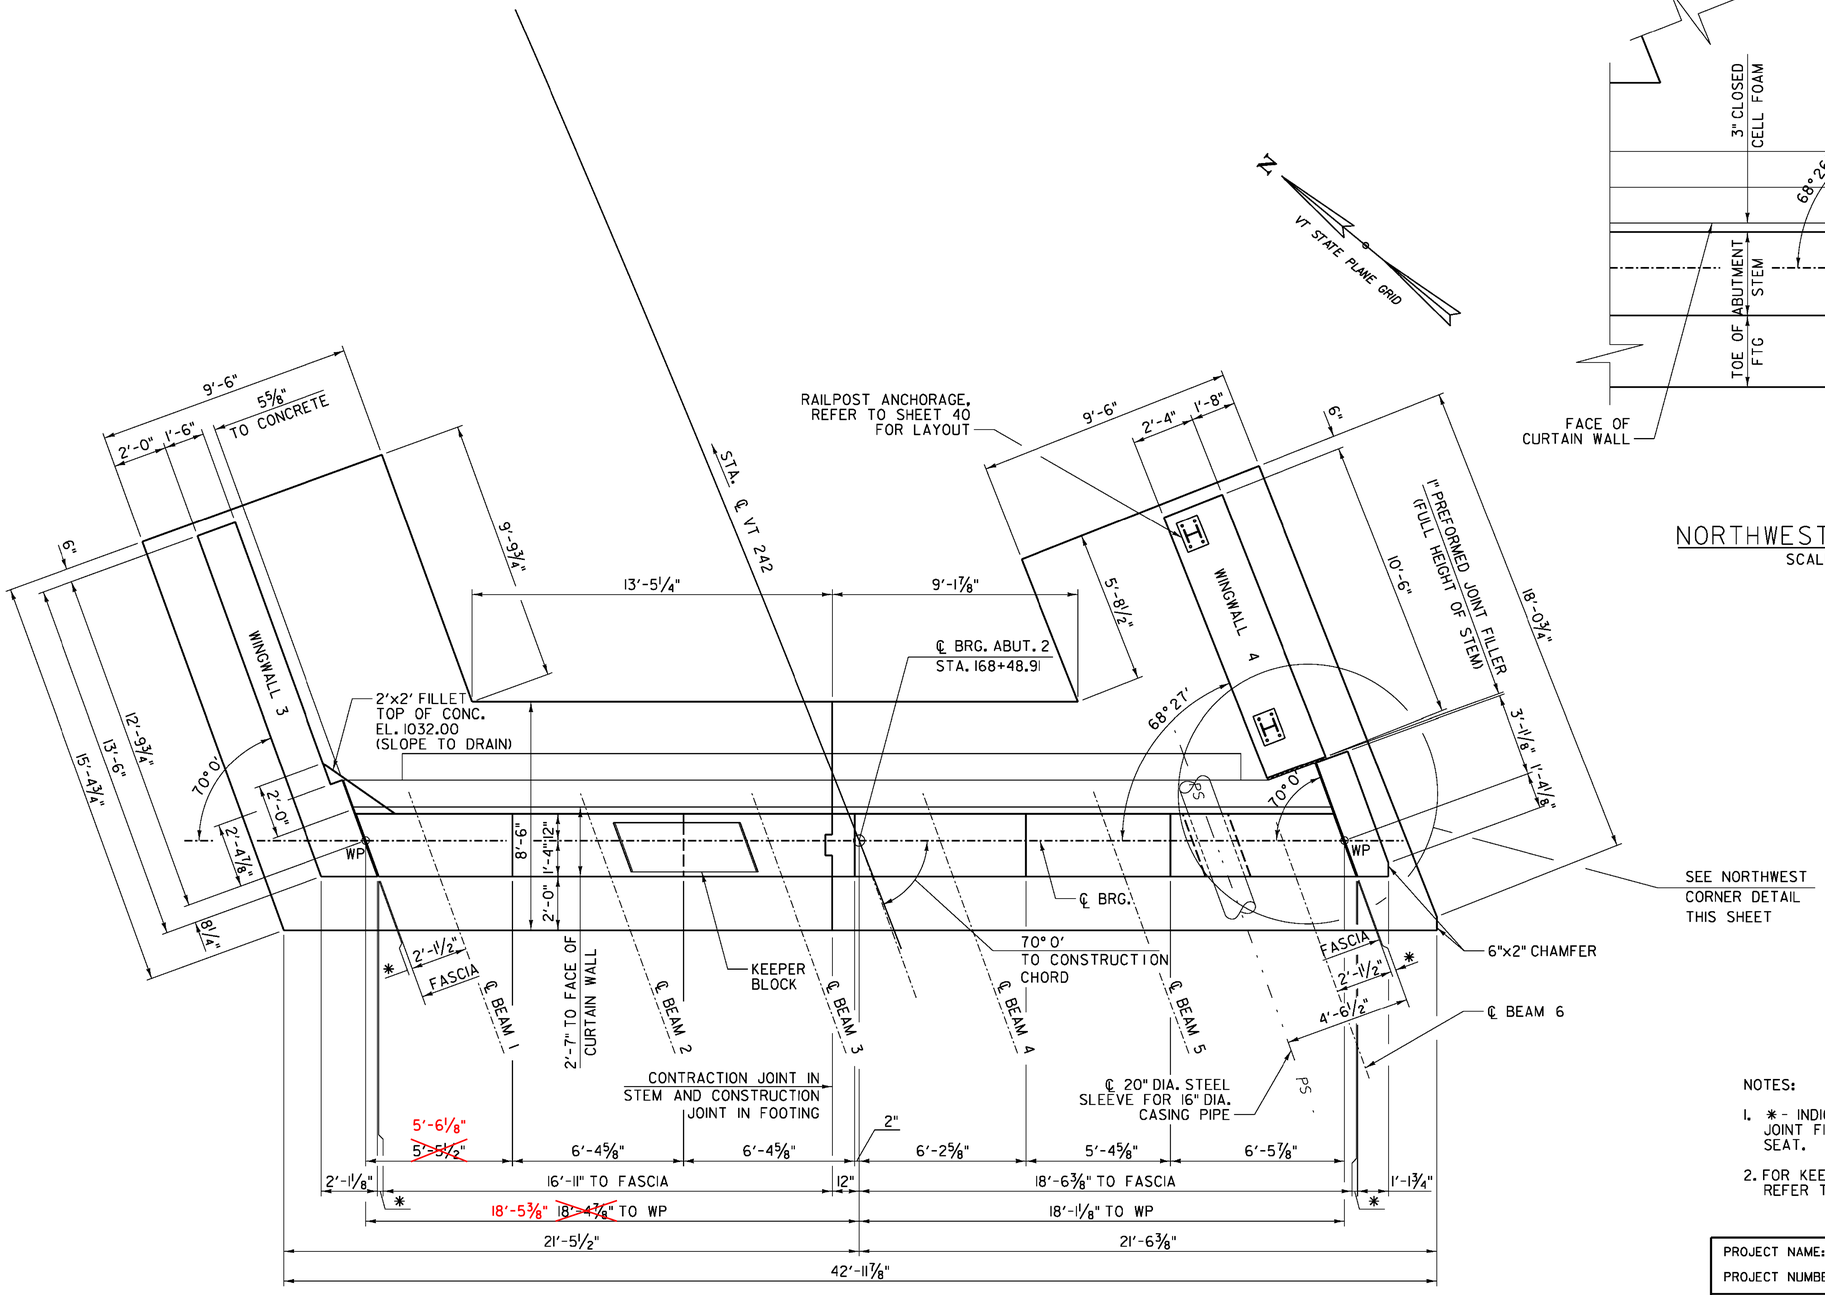

NORTHWEST CORNER DETAIL

SCALE: ½" = 1'-0"

ABUTMENT NO. 2 PLAN

SCALE: ⅜" = 1'-0"

NOTES:

1. ✱ - INDICATES ½" PREFORMED JOINT FILLER ABOVE BEAM SEAT.
2. FOR KEEPER BLOCK DETAIL REFER TO SHEET 31.

Stantec

PROJECT NAME: JAY	
PROJECT NUMBER: BHF 0278(3)	
FILE NAME: z12c154abuts.dgn	PLOT DATE: 8/16/2016
PROJECT LEADER: M. CHENETTE	DRAWN BY: J. SOTER
DESIGNED BY: N. TIRK	CHECKED BY: T. KNIGHT
ABUTMENT NO. 2 PLAN	SHEET 34 OF 72