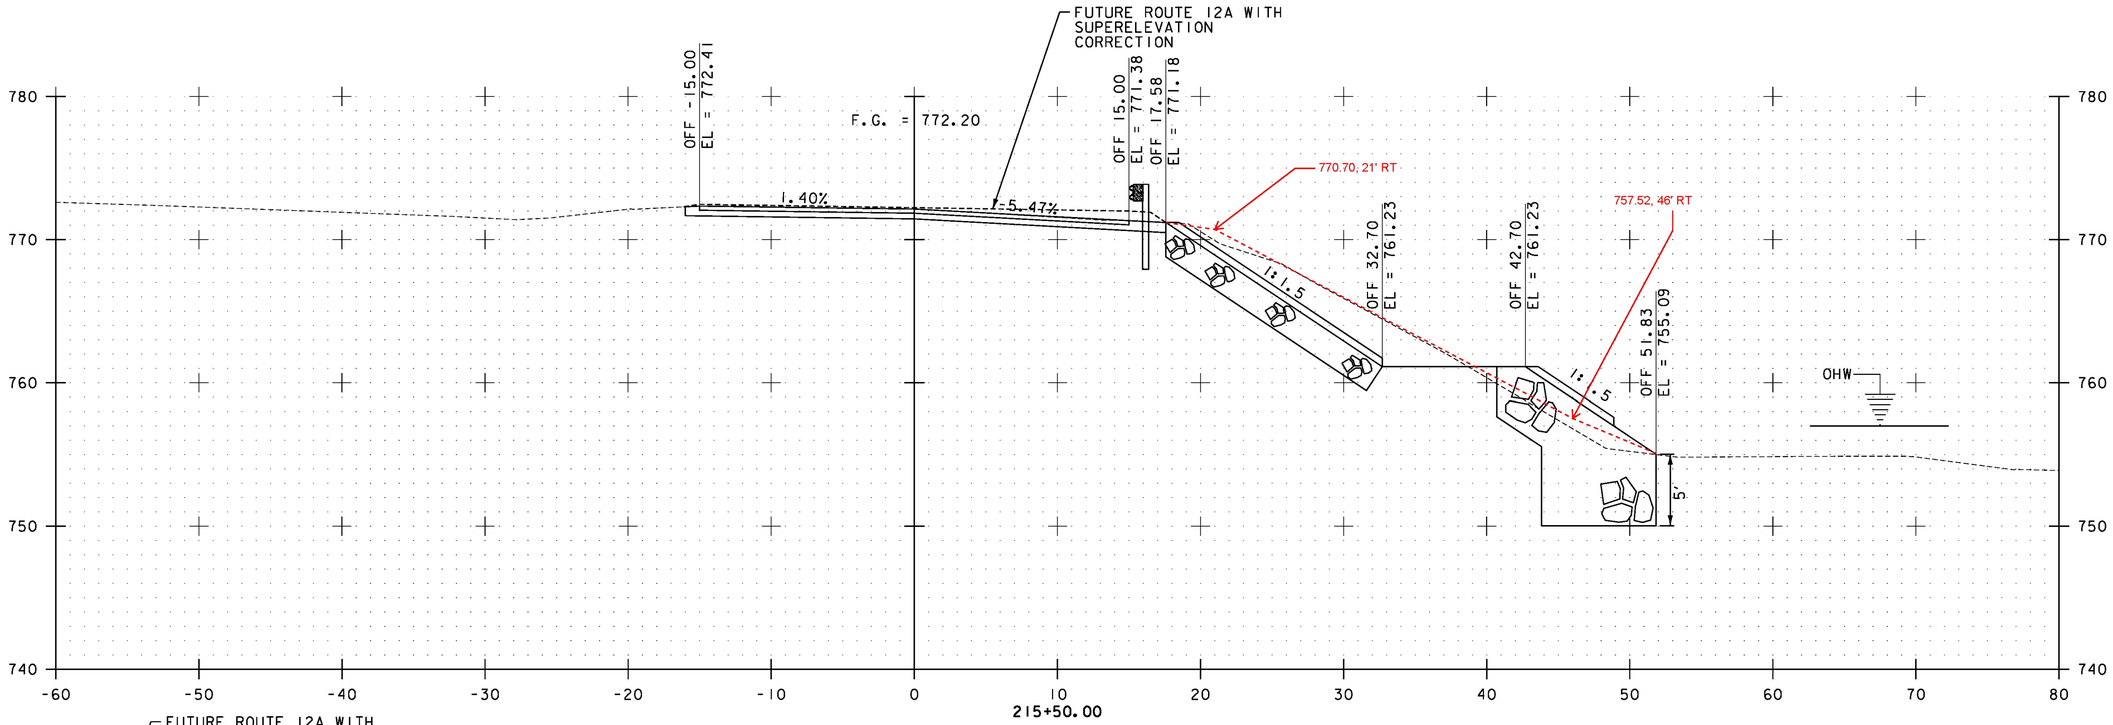

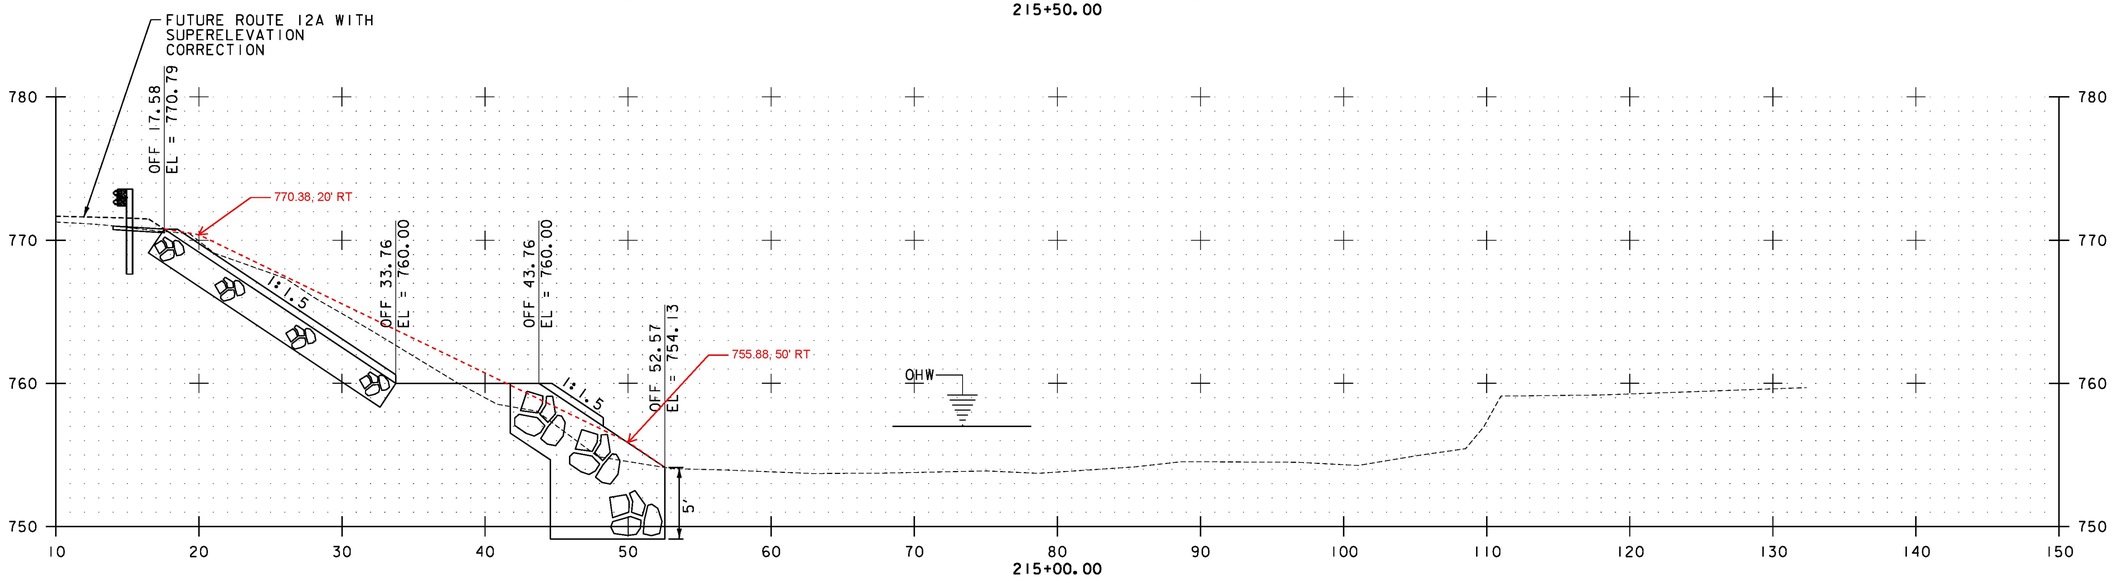

NOTE: REFER TO SHEET 4 FOR MATERIAL TYPES

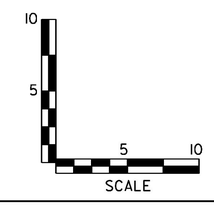

Stantec

STA. 215+00.00 TO STA. 215+50.00

PROJECT NAME: BRAINTREE
PROJECT NUMBER: ER STP 0187(12)

FILE NAME: zl2c526xs.dgn
PROJECT LEADER: G. EDWARDS
DESIGNED BY: I. MAYNARD
ROUTE 12A SECTIONS SHEET 10

PLOT DATE: 1/10/2014
DRAWN BY: G. BURGMEIER
CHECKED BY: M. FOISY
SHEET 48 OF 72