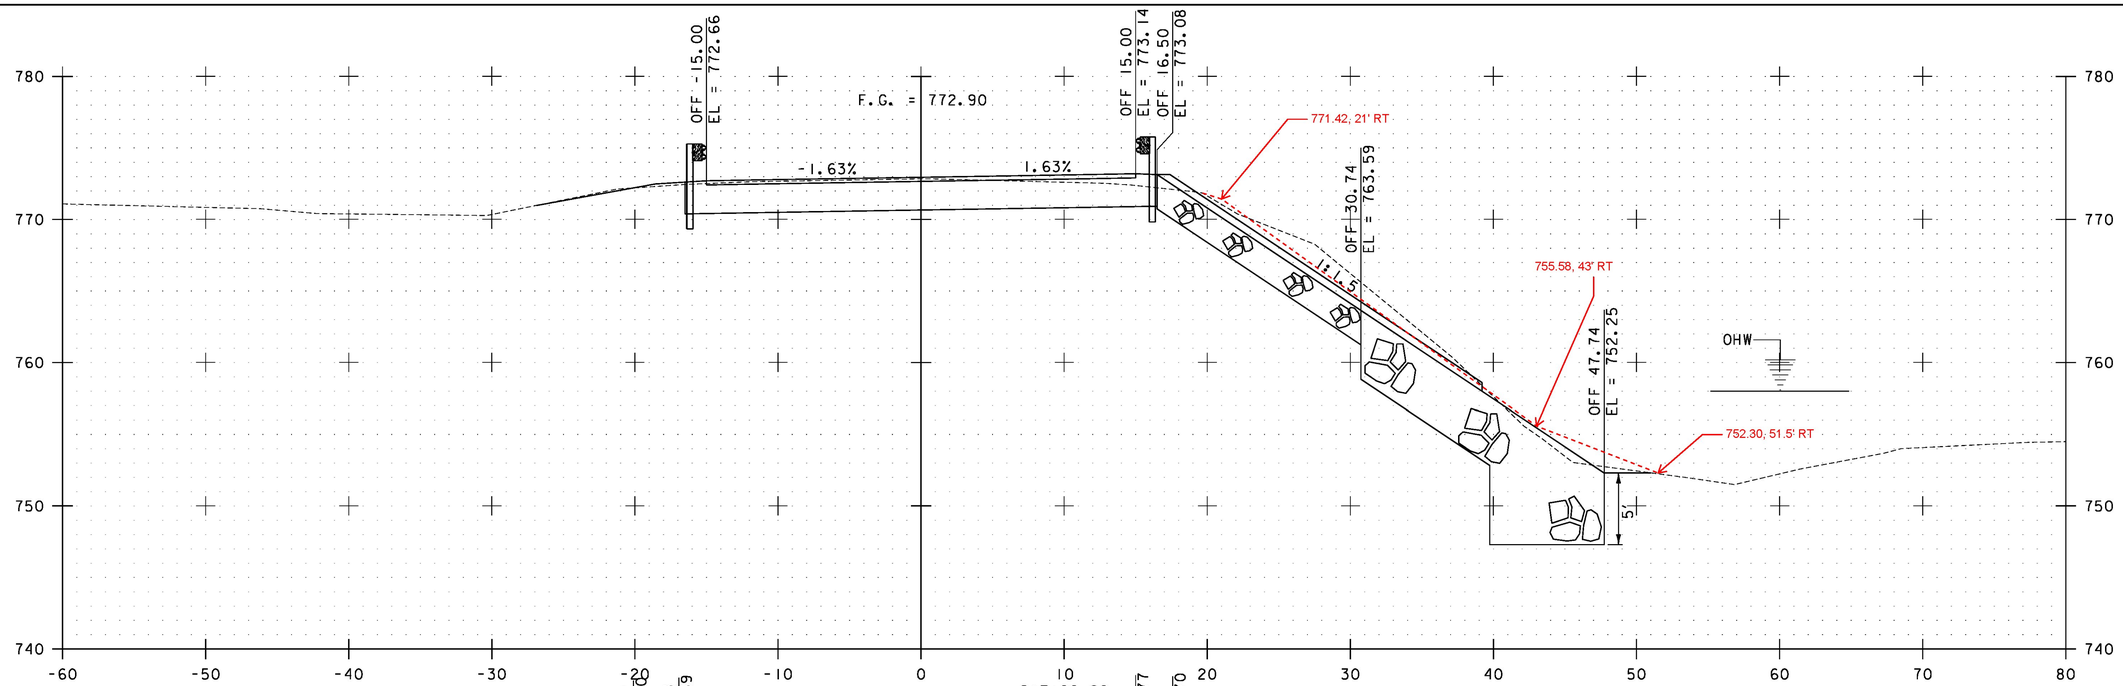

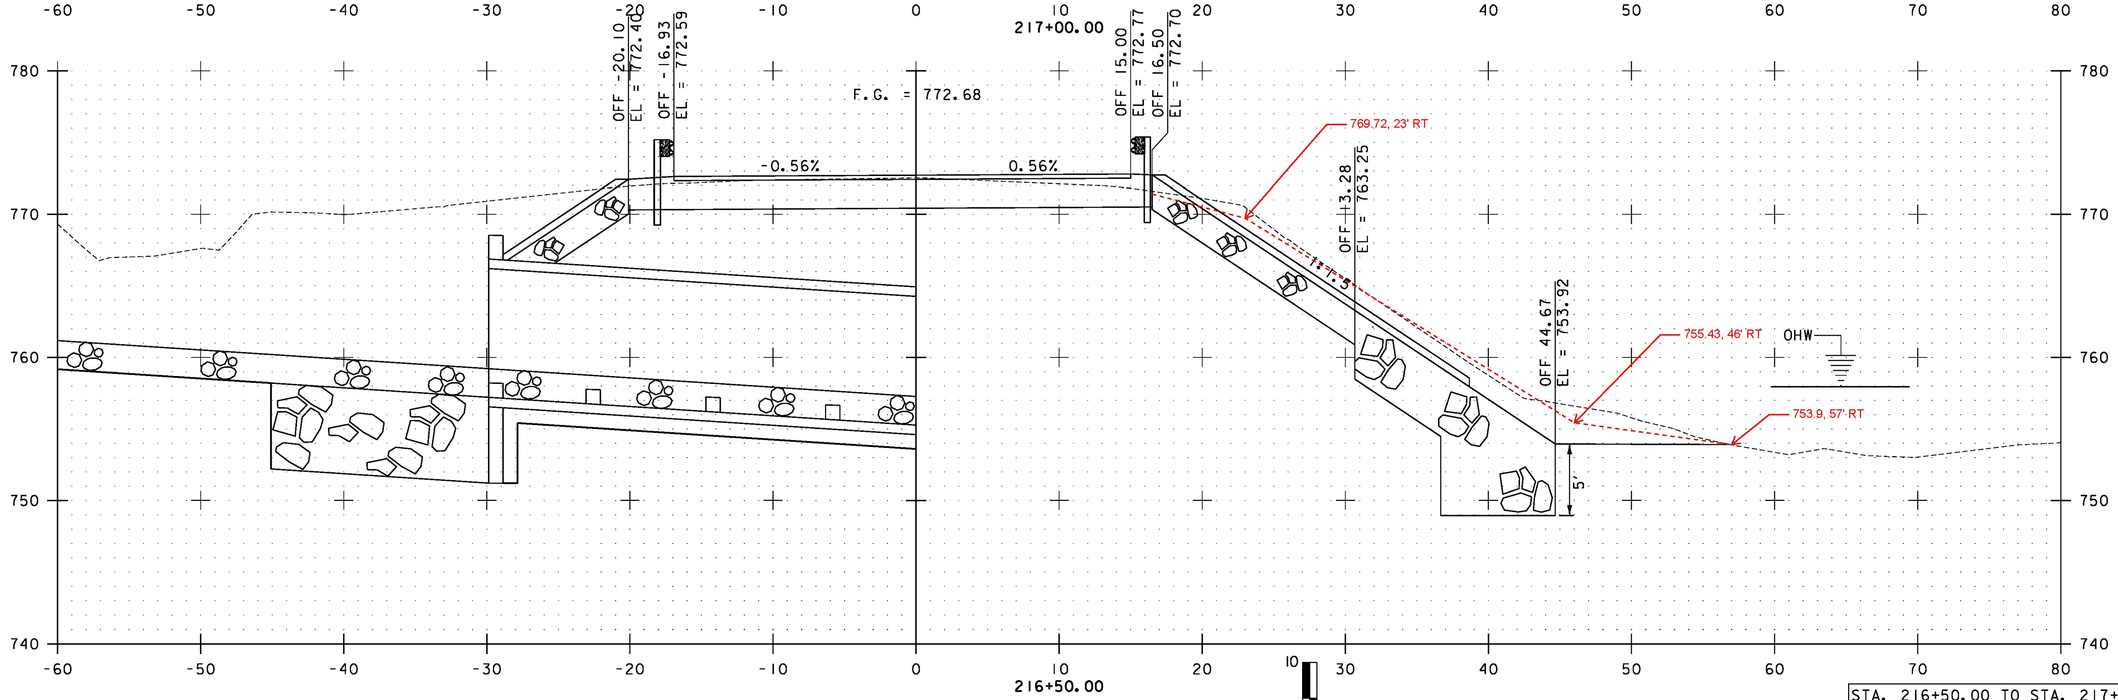

STA. 216+50.00 TO STA. 217+00.00

NOTE: REFER TO SHEET 4 FOR MATERIAL TYPES

SCALE

Stantec

PROJECT NAME: BRAINTREE	
PROJECT NUMBER: ER STP 0187(12)	
FILE NAME: zl2c526xs.dgn	PLOT DATE: 1/10/2014
PROJECT LEADER: G. EDWARDS	DRAWN BY: G. BURGMEIER
DESIGNED BY: I. MAYNARD	CHECKED BY: M. FOISY
ROUTE 12A SECTIONS SHEET 12	SHEET 50 OF 72