DIRECTION	MILEPOINT	LOCATION CODE (SHEET 2)	SIGN CODE	WIDTH (IN)	HEIGHT (IN)	SHEETING REMARKS	SIGN LEGEND	NEW SIGNS "A"	NEW SIGNS "B"	EXISTING SIGNS RETAIN	EXISTING SIGNS SALVAGE FROM	EXISTING SIGNS SALVAGE TO	EXISTING SIGNS REMOVE	EXIST POST RETAIN	EXIST POST REMOVE	NUMBER OF NEW POSTS	SQUARE STEEL (IN) 1.75 (LB / FT) 1.88	SQUARE STEEL (IN) 2.00 (LB / FT) 2.42	SQUARE STEEL (IN) 2.50 (LB / FT) 3.35	FOUNDATION	TUBULAR STEEL Ø (IN) 3.00 (LB / FT) 7.60	TUBULAR STEEL Ø (IN) 3.50 (LB / FT) 9.00	TUBULAR STEEL Ø (IN) 4.00 (LB / FT) 10.80	TUBULAR STEEL Ø (IN) 5.00 (LB / FT) 14.60	SIGN FRAME REQUIRED	REMARKS	SIGN DETAIL LOCATION SHSM	SIGN DETAIL LOCATION PROJECT SHEET #	SIGN DETAIL LOCATION STANDARD SHEET #
ORWELL VT-73 EB							FY-FLUORESCENT YELLOW FYG-FLUORESCENT YELLOW GREEN																				"SHSM"-STANDARD HIGHWAY SIGNS AND MARKINGS			
EB	0.021	A	VR-041	24	24		THROUGH WAY BEGINS HERE						1		X														
		B	VR-040	24	24		THROUGH WAY ENDS HERE						1																
		A	R2-1	24	30								1																
		A	R2-1	24	30			5.00								1		13.75 X								X		
EB	0.064	A	D2-1	72	10		ROUTE MARKER & D-BOARD ASSEMBLY						1		X														
		A	D2-1	72	10								1																
		A	M3-2	24	12								1																
		A	M1-5	24	24								1																
		A	VD2-1	72	12		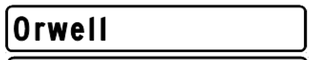	6.00								2		17.0 X 16.5									8	
		A	VD2-1	72	12		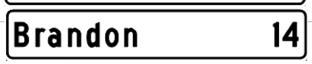	6.00																			8	
		A	M3-2	24	12	GRN/ WHT		2.00																				E-136b
		A	M1-5	24	24	GRN/ WHT		4.00																				E-136b
EB	0.102	A	W11-7	30	30		EQUESTRIAN SYMBOL						1		X														
		A	VW-060	30	30		HIDDEN DRIVES						1																
EB	~~0.127~~ 0.130	A	VW-060	30	30			6.25								1		14.75 X								INSTALL ~~130~~ 148 EAST OF EXISTING		9	
							SHEET TOTALS	29.25	0.00	0	0	0	9	0	0	4		~~60.0~~ 62.0		0	0.0	0.0	0.0	0.0					
								SF	SF	EA	EA	EA	EA	EA	EA	EA		FT		EA	LB	LB	LB	LB					
							TOWN DIRECTIONAL TOTALS	285.3	0.0	1	3	3	56	0	0	35		525.0		0		0.0							

SIGN SUMMARY SHEET

VERMONT AGENCY OF TRANSPORTATION

PROJECT NAME: STATEWIDE-SOUTHWEST
PROJECT NUMBER: STPG SIGN(47)
FILE NAME: z12c534TSS.xlsm
PROJECT MANAGER: D. BRYANT
DESIGNED BY: B. TOOTHAKER
ORWELL EB SHEET 1
PLOT DATE: 9/12/2014
DRAWN BY: B. TOOTHAKER
CHECKED K. KERN
SHEET 14 OF 107