DIRECTION	MILEPOINT	LOCATION CODE (SHEET 2)	SIGN CODE	WIDTH (IN)	HEIGHT (IN)	SHEETING REMARKS	SIGN LEGEND	NEW SIGNS "A"	NEW SIGNS "B"	EXISTING SIGNS RETAIN	EXISTING SIGNS SALVAGE FROM	EXISTING SIGNS SALVAGE TO	EXISTING SIGNS REMOVE	EXIST POST RETAIN	EXIST POST REMOVE	NUMBER OF NEW POSTS	SQUARE STEEL (IN) 1.75 (LB / FT) 1.88	SQUARE STEEL (IN) 2.00 (LB / FT) 2.42	SQUARE STEEL (IN) 2.50 (LB / FT) 3.35	TUBULAR STEEL Ø (IN) FOUNDATION	TUBULAR STEEL Ø (IN) 3.00 (LB / FT) 7.60	TUBULAR STEEL Ø (IN) 3.50 (LB / FT) 9.00	TUBULAR STEEL Ø (IN) 4.00 (LB / FT) 10.80	TUBULAR STEEL Ø (IN) 5.00 (LB / FT) 14.60	SIGN FRAME REQUIRED	REMARKS	SIGN DETAIL LOCATION SHSM	SIGN DETAIL LOCATION PROJECT SHEET #	SIGN DETAIL LOCATION STANDARD SHEET #
ORWELL VT-73 WB							FY-FLUORESCENT YELLOW FYG-FLUORESCENT YELLOW GREEN																			"SHSM"-STANDARD HIGHWAY SIGNS AND MARKINGS			
		F	D1-1A	72	10								1																
		F	D1-1M	72	10								1																
		F	VD1-1a	72	12		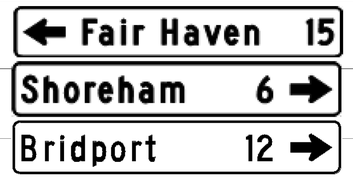	6.00																		EXISTING POST WAS DAMAGED		7	
		F	VD1-1a	72	12			6.00								2		14.0 X 14.5										7	
		F	VD1-1a	72	12			6.00																				7	
WB	0.109	F	W3-1	36	36								1	X	X											RETAINED OLD POST			
		F	W3-1	36	36			9.00								2		X									X		
WB	0.079	F	CUSTOM	72	34			17.00								2			12.0 X 11.5							INSTALL 175 FT EAST OF ROUTE MARKER ASSEMBLY		10	
		F	CUSTOM	72	14			7.00																		(2) SOIL BEARING SLIP BASES		10	
		F	CUSTOM	10	60			4.17																		SINGLE-SIDED OVERLAY PLAQUE		10	
		E/F	CUSTOM	10	60			4.17																		DOUBLE-SIDED OVERLAY PLAQUE		10	
WB	0.048	F	M3-1	24	12		ROUTE MARKER ASSEMBLY						1	X															
		F	M1-5A	24	24								1																
		F	M6-1	21	15								1																
		F	M3-3	24	12								1																
							SHEET TOTALS	59.34 ~~59.33~~	0.00	0	0	0	7	0	0	4		52.0 ~~60.0~~		0	0.0	0.0	0.0	0.0					
								SF	SF	EA	EA	EA	EA	EA	EA	EA		FT		EA	LB	LB	LB	LB					
							TOWN DIRECTIONAL TOTALS	407.4	0.0	1	3	3	73	0	0	45		675.0		0		0.0							

SIGN SUMMARY SHEET

VERMONT AGENCY OF TRANSPORTATION

PROJECT NAME: STATEWIDE-SOUTHWEST
PROJECT NUMBER: STPG SIGN(47)

FILE NAME: z12c534TSS.xlsm
PROJECT MANAGER: D. BRYANT
DESIGNED BY: B. TOOTHAKER
ORWELL WB SHEET 9

PLOT DATE: 9/12/2014
DRAWN BY: B. TOOTHAKER
CHECKED: K. KERN