DIRECTION	MILEPOINT	LOCATION CODE (SHEET 2)	SIGN CODE	WIDTH (IN)	HEIGHT (IN)	SHEETING REMARKS	SIGN LEGEND	NEW SIGNS "A"	NEW SIGNS "B"	EXISTING SIGNS RETAIN	EXISTING SIGNS SALVAGE FROM	EXISTING SIGNS SALVAGE TO	EXISTING SIGNS REMOVE	EXIST POST RETAIN	EXIST POST REMOVE	NUMBER OF NEW POSTS	SQUARE STEEL (IN) 1.75 (LB / FT) 1.88	SQUARE STEEL (IN) 2.00 (LB / FT) 2.42	SQUARE STEEL (IN) 2.50 (LB / FT) 3.35	TUBULAR STEEL Ø (IN) FOUNDATION	TUBULAR STEEL Ø (IN) 3.00 (LB / FT) 7.60	TUBULAR STEEL Ø (IN) 3.50 (LB / FT) 9.00	TUBULAR STEEL Ø (IN) 4.00 (LB / FT) 10.80	TUBULAR STEEL Ø (IN) 5.00 (LB / FT) 14.60	SIGN FRAME REQUIRED	REMARKS	SIGN DETAIL LOCATION SHSM	SIGN DETAIL LOCATION PROJECT SHEET #	SIGN DETAIL LOCATION STANDARD SHEET #
ORWELL VT-73 WB							FY-FLUORESCENT YELLOW FYG-FLUORESCENT YELLOW GREEN																			"SHSM"-STANDARD HIGHWAY SIGNS AND MARKINGS			
		F	M3-4	24	12								1																
		F	M6-1	21	15								1																
		F	M1-5	24	24								1																
		F	M1-5	24	24								1																
		F	M6-3	21	15								1																
		F	M3-3	24	12	GRN/ WHT		2.00																					E-136b
		F	M1-5	24	24	GRN/ WHT	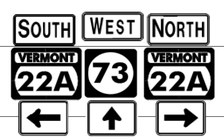	4.00																				E-136b
		F	M6-1	21	15	GRN/ WHT		2.19																					E-136b
		F	M3-4	24	12	BLK/ WHT		2.00																					E-136c
		F	M1-5	24	24	BLK/ WHT		4.00																					E-136c
		F	M6-3	21	15	BLK/ WHT		2.19																					E-136c
		F	M3-1	24	12	GRN/ WHT		2.00																					E-136b
		F	M1-5	24	24	GRN/ WHT		4.00																					E-136b
		F	M6-1	21	15	GRN/ WHT		2.19																					E-136b
WB	0.015	F	R1-1	36	36								~~1~~	X															
							SHEET TOTALS	~~24.56~~ 24.57	0.00	0	0	0	~~6~~ 5	0	0	0		0.0		0	0.0	0.0	0.0	0.0					
								SF	SF	EA	EA	EA	EA	EA	EA	EA		FT		EA	LB	LB	LB	LB					
							TOWN DIRECTIONAL TOTALS	407.4	0.0	1	3	3	73	0	0	45		675.0		0		0.0							

SIGN SUMMARY SHEET

VERMONT AGENCY OF TRANSPORTATION

PROJECT NAME: **STATEWIDE-SOUTHWEST**
PROJECT NUMBER: **STPG SIGN(47)**

FILE NAME: **z12c534TSS.xlsm**
PROJECT MANAGER: **D. BRYANT**
DESIGNED BY: **B. TOOTHAKER**
ORWELL WB SHEET 10

PLOT DATE: **9/12/2014**
DRAWN BY: **B. TOOTHAKER**
CHECKED **K. KERN**