DIRECTION	MILEPOINT	LOCATION CODE (SHEET 2)	SIGN CODE	WIDTH (IN)	HEIGHT (IN)	SHEETING REMARKS	SIGN LEGEND	NEW SIGNS "A"	NEW SIGNS "B"	EXISTING SIGNS RETAIN	EXISTING SIGNS SALVAGE FROM	EXISTING SIGNS SALVAGE TO	EXISTING SIGNS REMOVE	EXIST POST RETAIN	EXIST POST REMOVE	NUMBER OF NEW POSTS	SQUARE STEEL (IN) 1.75 (LB / FT) 1.88	SQUARE STEEL (IN) 2.00 (LB / FT) 2.42	SQUARE STEEL (IN) 2.50 (LB / FT) 3.35	TUBULAR STEEL Ø (IN) FOUNDATION	TUBULAR STEEL Ø (IN) 3.00 (LB / FT) 7.60	TUBULAR STEEL Ø (IN) 3.50 (LB / FT) 9.00	TUBULAR STEEL Ø (IN) 4.00 (LB / FT) 10.80	TUBULAR STEEL Ø (IN) 5.00 (LB / FT) 14.60	SIGN FRAME REQUIRED	REMARKS	SIGN DETAIL LOCATION SHSM	SIGN DETAIL LOCATION PROJECT SHEET #	SIGN DETAIL LOCATION STANDARD SHEET #
SHOREHAM VT-74 EB							FY-FLUORESCENT YELLOW FYG-FLUORESCENT YELLOW GREEN																			"SHSM"-STANDARD HIGHWAY SIGNS AND MARKINGS			
		A	M1-5A	24	24		MM PLAQUE 0040				I		1 I																
		A	M2-1	21	15	BLK/ WHT		2.19				I				1		16.5 X											E-136c
		A	M1-5	24	24	BLK/ WHT		4.00																					E-136c
EB	0.426	A	D1-1A	72	10		D-BOARD MARKER ASSEMBLY						1		X														
		A	D1-1A	72	10								1																
		A	D1-1A	72	10								1																
		A	D1-1A	72	10								1																
		A	VD1-1a	72	12		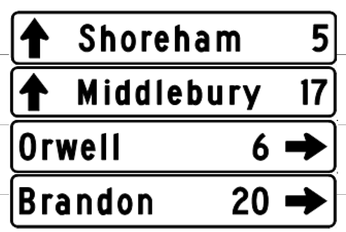	6.00								2		11.75 X 11.75							(2) SOIL BEARING SLIP BASES		7	
		A	VD1-1a	72	12			6.00																				7	
		A	VD1-1a	72	12			6.00																				7	
		A	VD1-1a	72	12			6.00																				7	
EB	0.475	A	M4-5	24	12		ROUTE MARKER ASSEMBLY						1	X															
		A	M3-1	24	12								1																
		A	M1-5A	24	24								1																
		A	M6-3	21	15								1																
							SHEET TOTALS	30.19	0.00	0	I ~~0~~	I ~~0~~	10 ~~9~~	0	0	3		40.0 ~~45.0~~		0	0.0	0.0	0.0	0.0					
								SF	SF	EA	EA	EA	EA	EA	EA	EA		FT		EA	LB	LB	LB	LB					
							TOWN DIRECTIONAL TOTALS	771.0	0.0	1	2	2	137	0	0	88		1320.0		0		0.0							

SIGN SUMMARY SHEET

VERMONT AGENCY OF TRANSPORTATION

PROJECT NAME: STATEWIDE-SOUTHWEST
PROJECT NUMBER: STPG SIGN(47)

FILE NAME: z12c534TSS.xlsm
PROJECT MANAGER: D. BRYANT
DESIGNED BY: B. TOOTHAKER
SHOREHAM EB SHEET 3

PLOT DATE: 9/12/2014
DRAWN BY: B. TOOTHAKER
CHECKED: K. KERN
SHEET 39 OF 107