DIRECTION	MILEPOINT	LOCATION CODE (SHEET 2)	SIGN CODE	WIDTH (IN)	HEIGHT (IN)	SHEETING REMARKS	SIGN LEGEND	NEW SIGNS "A"	NEW SIGNS "B"	EXISTING SIGNS RETAIN	EXISTING SIGNS SALVAGE FROM	EXISTING SIGNS SALVAGE TO	EXISTING SIGNS REMOVE	EXIST POST RETAIN	EXIST POST REMOVE	NUMBER OF NEW POSTS	SQUARE STEEL (IN) (LB / FT) 1.75 / 1.88	SQUARE STEEL (IN) (LB / FT) 2.00 / 2.42	SQUARE STEEL (IN) (LB / FT) 2.50 / 3.35	TUBULAR STEEL Ø (IN) FOUNDATION	TUBULAR STEEL Ø (IN) (LB / FT) 3.00 / 7.60	TUBULAR STEEL Ø (IN) (LB / FT) 3.50 / 9.00	TUBULAR STEEL Ø (IN) (LB / FT) 4.00 / 10.80	TUBULAR STEEL Ø (IN) (LB / FT) 5.00 / 14.60	SIGN FRAME REQUIRED	REMARKS	SIGN DETAIL LOCATION SHSM	SIGN DETAIL LOCATION PROJECT SHEET #	SIGN DETAIL LOCATION STANDARD SHEET #
SHOREHAM VT-74 EB							FY-FLUORESCENT YELLOW FYG-FLUORESCENT YELLOW GREEN																			"SHSM"-STANDARD HIGHWAY SIGNS AND MARKINGS			
EB	4.862	A	W2-2MR	30	30								1		X													
		A	W2-8R	30	30			6.25								1		14.25 X									9	
EB	4.876	C	VR-017	24	30								1		X													
		C	VR-017	24	30			5.00								1		13.0 X								SCHOOL RD (TH-54)		9	
EB	4.881	D	R1-1	30	30								1		X													
		D	R1-1	30	30			6.25								1		13.75 X								SCHOOL RD (TH-54); REQUIRES VEGETATION CLEARING	X		
EB	4.883	D	R1-1	30	30			5.00								1												
		D	~~R1-1~~ VR-017	30	30			6.25								1		13.75 X								SCHOOL RD (TH-54)	X		
EB	4.884	A/B	D3-1	UNK.	UNK.								1		X													
		A/B	D3-1	40	12		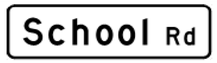	3.33								1		9.75 X									11	
EB	4.885	C	VR-017	24	30			6.25								1												
		C	~~VR-017~~ RI-I	24	30	MM PLAQUE 0488		~~5.00~~			I	I	I			1		13.0 X								SCHOOL RD (TH-54)		9	
EB	4.890	D	R1-1	30	30								1	X	~~X~~											RETAINED EXISTING POST			
		D	R1-1	30	30			~~6.25~~								~~1~~		~~X~~								SCHOOL ST (TH-30)	X		
EB	4.896	C	VR-017	24	30								1		X													
			SHEET TOTALS					38.33	0.00	0	~~0~~ I	~~0~~ I	~~8~~ 9	0	0	~~7~~		~~105.0~~ 77.5		0	0.0	0.0	0.0	0.0					
								SF	SF	EA	EA	EA	EA	EA	EA	EA		FT		EA	LB	LB	LB	LB					
			TOWN DIRECTIONAL TOTALS					771.0	0.0	1	2	2	137	0	0	88		1320.0		0	0.0							

SIGN SUMMARY SHEET

VERMONT AGENCY OF TRANSPORTATION

PROJECT NAME: STATEWIDE-SOUTHWEST
PROJECT NUMBER: STPG SIGN(47)
FILE NAME: z12c534TSS.xlsm
PROJECT MANAGER: D. BRYANT
DESIGNED BY: B. TOOTHAKER
SHOREHAM EB SHEET 12
PLOT DATE: 9/12/2014
DRAWN BY: B. TOOTHAKER
CHECKED K. KERN