DIRECTION	MILEPOINT	LOCATION CODE (SHEET 2)	SIGN CODE	WIDTH (IN)	HEIGHT (IN)	SHEETING REMARKS	SIGN LEGEND	NEW SIGNS "A"	NEW SIGNS "B"	EXISTING SIGNS RETAIN	EXISTING SIGNS SALVAGE FROM	EXISTING SIGNS SALVAGE TO	EXISTING SIGNS REMOVE	EXIST POST RETAIN	EXIST POST REMOVE	NUMBER OF NEW POSTS	SQUARE STEEL (IN) (LB / FT) 1.75 / 1.88	SQUARE STEEL (IN) (LB / FT) 2.00 / 2.42	SQUARE STEEL (IN) (LB / FT) 2.50 / 3.35	TUBULAR STEEL Ø (IN) FOUNDATION	TUBULAR STEEL Ø (IN) (LB / FT) 3.00 / 7.60	TUBULAR STEEL Ø (IN) (LB / FT) 3.50 / 9.00	TUBULAR STEEL Ø (IN) (LB / FT) 4.00 / 10.80	TUBULAR STEEL Ø (IN) (LB / FT) 5.00 / 14.60	SIGN FRAME REQUIRED	REMARKS	SIGN DETAIL LOCATION SHSM	SIGN DETAIL LOCATION PROJECT SHEET #	SIGN DETAIL LOCATION STANDARD SHEET #
SHOREHAM VT-74 EB							FY-FLUORESCENT YELLOW FYG-FLUORESCENT YELLOW GREEN																			"SHSM"-STANDARD HIGHWAY SIGNS AND MARKINGS			
		A	VD2-1	72	12			6.00																			8	
EB	5.360	A	W1-2L	30	30			6.25								1		15.75 X								INSTALL 285 FT EAST OF D-BOARD ASSEMBLY	X		
		A	W13-1P	18	18			2.25																			X		
EB	5.490	A	VW-054R	30	30								1	X															
		A	VW-054R	30	30			6.25																			X		
EB	5.604	A	R2-1	24	30								1	X															
		A	R2-1	24	30			5.00																			X		
EB	5.763	A/B	D3-1	UNK.	UNK.								1		X														
		A/B	D3-1	60	12		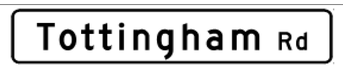	5.00								2		13.25 X 11.5								TOTTINGHAM RD (TH-34)		12	
EB	5.765	C	VR-079	24	30								1		X														
		C	W14-1	30	30		DEAD END				1		1														SALVAGE AND MOUNT IN NEW LOCATION			
		C	VR-079	24	30			5.00								1		13.25 X								TOTTINGHAM RD (TH-34)		9	
EB	5.765	C	W14-1	30	30		DEAD END					1				1										TOTTINGHAM RD (TH-34); INSTALL 20 FT FROM LEGAL LOAD LIMIT, AWAY FROM VT-74			
EB	5.770	D	R1-1	30	30		MM PLAQUE 0576				1		1	X													EXISTING POST WAS DAMAGED			
		D	R1-1	30	30			6.25				1				1		10.75 X								TOTTINGHAM RD (TH-34) USED OLD ANCHOR	X		
SIGN SUMMARY SHEET							SHEET TOTALS	42.00	0.00	0	~~1~~ 2	~~1~~ 2	~~6~~ 7	0	0	5		~~75.0~~ 78.25		0	0.0	0.0	0.0	0.0					
								SF	SF	EA	EA	EA	EA	EA	EA	EA		FT		EA	LB	LB	LB	LB					
VERMONT AGENCY OF TRANSPORTATION							TOWN DIRECTIONAL TOTALS	771.0	0.0	1	2	2	137	0	0	88		1320.0		0		0.0							

PROJECT NAME: **STATEWIDE-SOUTHWEST**
PROJECT NUMBER: **STPG SIGN(47)**

FILE NAME: **z12c534TSS.xlsm**
PROJECT MANAGER: **D. BRYANT**
DESIGNED BY: **B. TOOTHAKER**
SHOREHAM EB SHEET 17

PLOT DATE: **9/12/2014**
DRAWN BY: **B. TOOTHAKER**
CHECKED **K. KERN**