DIRECTION	MILEPOINT	LOCATION CODE (SHEET 2)	SIGN CODE	WIDTH (IN)	HEIGHT (IN)	SHEETING REMARKS	SIGN LEGEND	NEW SIGNS "A"	NEW SIGNS "B"	EXISTING SIGNS RETAIN	EXISTING SIGNS SALVAGE FROM	EXISTING SIGNS SALVAGE TO	EXISTING SIGNS REMOVE	EXIST POST RETAIN	EXIST POST REMOVE	NUMBER OF NEW POSTS	SQUARE STEEL (IN) (LB / FT) 1.75 / 1.88	SQUARE STEEL (IN) (LB / FT) 2.00 / 2.42	SQUARE STEEL (IN) (LB / FT) 2.50 / 3.35	TUBULAR STEEL Ø (IN) FOUNDATION	TUBULAR STEEL Ø (IN) (LB / FT) 3.00 / 7.60	TUBULAR STEEL Ø (IN) (LB / FT) 3.50 / 9.00	TUBULAR STEEL Ø (IN) (LB / FT) 4.00 / 10.80	TUBULAR STEEL Ø (IN) (LB / FT) 5.00 / 14.60	SIGN FRAME REQUIRED	REMARKS	SIGN DETAIL LOCATION SHSM	SIGN DETAIL LOCATION PROJECT SHEET #	SIGN DETAIL LOCATION STANDARD SHEET #
SHOREHAM VT-74 WB							FY-FLUORESCENT YELLOW FYG-FLUORESCENT YELLOW GREEN																			"SHSM"-STANDARD HIGHWAY SIGNS AND MARKINGS			
WB	9.883	F	W1-2R	30	30		RIGHT CURVE						1	X														
		F	W13-1	18	18		35 MPH						1															
		F	UNK	UNK.	UNK.		CHAMPLAIN BYWAY					1														INSTALL SALVAGED SIGN ON EXISTING POST			
WB	9.868	F	W1-2R	30	30			6.25								1		15.75 X								INSTALL 80 FT WEST OF EXISTING	X		
		F	W13-1P	18	18			2.25																			X		
WB	8.824	F	UNK	UNK.	UNK.		CHAMPLAIN BYWAY				1		1		X													
WB	8.697	E/F	D3-1	UNK.	UNK.								1		X													
		E/F	D3-1	70	12			5.83								2		11.75 X 12.0										12	
WB	8.629	F	W1-2L	30	30		LEFT CURVE						1		X													
		F	W13-1P	18	18		25 M.P.H.						1															
WB	8.582	F	W1-10bL	36	36			9.00								1		15.0 X								INSTALL 250 FT WEST OF EXISTING	X		
		F	W13-1P	18	18			2.25																			X		
WB	8.556	F	W1-6L	48	24			8.00								2		13.25 X 12.25								INSTALL 80 FT EAST OF INTERSECTION	X		
WB	8.551	G	VR-017	24	30			5.00								1		13.25 X								DOOLITTLE RD (TH-15)		9	
WB	8.549	E	W1-6R	48	24		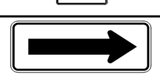	8.00								2		13.25 X 13.5								INSTALL 40 FT EAST OF INTERSECTION	X		
							SHEET TOTALS	46.58	0.00	0	1	1	6	0	0	9		120.0 ~~135.0~~		0	0.0	0.0	0.0	0.0					
								SF	SF	EA	EA	EA	EA	EA	EA	EA		FT		EA	LB	LB	LB	LB					
							TOWN DIRECTIONAL TOTALS	660.5	0.0	0	2	2	107	0	0	80		1200.0		0		0.0							

SIGN SUMMARY SHEET

VERMONT AGENCY OF TRANSPORTATION

PROJECT NAME: **STATEWIDE-SOUTHWEST**
PROJECT NUMBER: **STPG SIGN(47)**

FILE NAME: **z12c534TSS.xlsm**
PROJECT MANAGER: **D. BRYANT**
DESIGNED BY: **B. TOOTHAKER**
SHOREHAM WB SHEET 1

PLOT DATE: **9/15/2014**
DRAWN BY: **B. TOOTHAKER**
CHECKED **K. KERN**