DIRECTION	MILEPOINT	LOCATION CODE (SHEET 2)	SIGN CODE	WIDTH (IN)	HEIGHT (IN)	SHEETING REMARKS	SIGN LEGEND	NEW SIGNS "A"	NEW SIGNS "B"	EXISTING SIGNS RETAIN	EXISTING SIGNS SALVAGE FROM	EXISTING SIGNS SALVAGE TO	EXISTING SIGNS REMOVE	EXIST POST RETAIN	EXIST POST REMOVE	NUMBER OF NEW POSTS	SQUARE STEEL (IN) 1.75 (LB / FT) 1.88	SQUARE STEEL (IN) 2.00 (LB / FT) 2.42	SQUARE STEEL (IN) 2.50 (LB / FT) 3.35	FOUNDATION	TUBULAR STEEL Ø (IN) 3.00 (LB / FT) 7.60	TUBULAR STEEL Ø (IN) 3.50 (LB / FT) 9.00	TUBULAR STEEL Ø (IN) 4.00 (LB / FT) 10.80	TUBULAR STEEL Ø (IN) 5.00 (LB / FT) 14.60	SIGN FRAME REQUIRED	REMARKS	SIGN DETAIL LOCATION SHSM	SIGN DETAIL LOCATION PROJECT SHEET #	SIGN DETAIL LOCATION STANDARD SHEET #
SHOREHAM VT-74 WB							FY-FLUORESCENT YELLOW FYG-FLUORESCENT YELLOW GREEN																			"SHSM"-STANDARD HIGHWAY SIGNS AND MARKINGS			
		F	M6-1	21	15								1																
		F	M6-1	21	15								1																
		F	M3-3	24	12								1																
		F	M3-3	24	12	GRN/ WHT		2.00																		MOUNT NEW SIGNS ON EXISTING SIGN FRAME			E-136b
		F	M1-5	24	24	GRN/ WHT		4.00																					E-136b
		F	M6-1	21	15	GRN/ WHT		2.19																					E-136b
		F	M3-4	24	12	GRN/ WHT	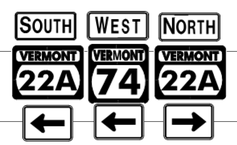	2.00																					E-136b
		F	M1-5	24	24	GRN/ WHT		4.00																					E-136b
		F	M6-1	21	15	GRN/ WHT		2.19																					E-136b
		F	M3-1	24	12	GRN/ WHT		2.00																					E-136b
		F	M1-5	24	24	GRN/ WHT		4.00																					E-136b
		F	M6-1	21	15	GRN/ WHT		2.19																					E-136b
WB	5.268	F	CUSTOM	72	34		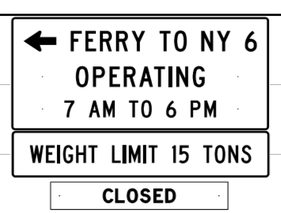	17.00								2		11.5 X 12.0								INSTALL 90 FT WEST OF EXISTING ROUTE MARKER ASSEMBLY		10	
		F	CUSTOM	72	14			7.00																		(2) SOIL BEARING SLIP BASE		10	
		F	CUSTOM	60	10			4.17																		SINGLE-SIDED OVERLAY PLAQUE		10	
							SHEET TOTALS	52.74 ~~52.73~~	0.00	0	0	0	3	0	0	2		23.5 ~~30.0~~		0	0.0	0.0	0.0	0.0					
								SF	SF	EA	EA	EA	EA	EA	EA	EA		FT		EA	LB	LB	LB	LB					
							TOWN DIRECTIONAL TOTALS	660.5	0.0	0	2	2	107	0	0	80		1200.0		0		0.0							

SIGN SUMMARY SHEET

VERMONT AGENCY OF TRANSPORTATION

PROJECT NAME: STATEWIDE-SOUTHWEST
PROJECT NUMBER: STPG SIGN(47)
FILE NAME: z12c534TSS.xlsm
PROJECT MANAGER: D. BRYANT
DESIGNED BY: B. TOOTHAKER
SHOREHAM WB SHEET 5
PLOT DATE: 9/15/2014
DRAWN BY: B. TOOTHAKER
CHECKED: K. KERN
SHEET 61 OF 107