DIRECTION	MILEPOINT	LOCATION CODE (SHEET 2)	SIGN CODE	WIDTH (IN)	HEIGHT (IN)	SHEETING REMARKS	SIGN LEGEND	NEW SIGNS "A"	NEW SIGNS "B"	EXISTING SIGNS RETAIN	EXISTING SIGNS SALVAGE FROM	EXISTING SIGNS SALVAGE TO	EXISTING SIGNS REMOVE	EXIST POST RETAIN	EXIST POST REMOVE	NUMBER OF NEW POSTS	SQUARE STEEL (IN) (LB / FT) 1.75 / 1.88	SQUARE STEEL (IN) (LB / FT) 2.00 / 2.42	SQUARE STEEL (IN) (LB / FT) 2.50 / 3.35	FOUNDATION	TUBULAR STEEL Ø (IN) (LB / FT) 3.00 / 7.60	TUBULAR STEEL Ø (IN) (LB / FT) 3.50 / 9.00	TUBULAR STEEL Ø (IN) (LB / FT) 4.00 / 10.80	TUBULAR STEEL Ø (IN) (LB / FT) 5.00 / 14.60	SIGN FRAME REQUIRED	REMARKS	SIGN DETAIL LOCATION SHSM	SIGN DETAIL LOCATION PROJECT SHEET #	SIGN DETAIL LOCATION STANDARD SHEET #
SHOREHAM VT-74 WB							FY-FLUORESCENT YELLOW FYG-FLUORESCENT YELLOW GREEN																				"SHSM"-STANDARD HIGHWAY SIGNS AND MARKINGS			
		E	W1-6R	48	24			8.00								2		14.25 X 14.5									X		
WB	4.808	E/F	D3-1	UNK.	UNK.								1		X											SIGN MISSING ON REMOVAL - POST ONLY			
		E/F	D3-1	62	12		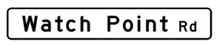	5.17								2		12.0 X 12.75								WATCH POINT RD (TH 5); FIELD LOCATE FOR VISIBILITY FROM VT74		12	
WB	4.806	F	W1-6L	48	24			8.00								2		14.25 X 14.75								INSTALL 10 FT WEST OF RIGHT ARROW	X		
WB	4.803	G	VR-017	24	30								1		X														
		G	VR-017	24	30			5.00								1		13.0 X										9	
WB	4.800	H	R1-1	30	30								1	X															
		H	R1-1	30	30			6.25																			X		
WB	4.763	F	R2-1	24	30								1	X															
		F	R2-1	24	30			5.00																		INSTALL DIRECTLY ACROSS FROM EB SPEED LIMIT 30	X		
WB	4.564	F	R2-1	24	30								1	X													EXISTING POST WAS DAMAGED			
		F	R2-1	24	30			5.00								1		14.5 X								INSTALL DIRECTLY ACROSS FROM EB SPEED LIMIT 40	X		
WB	4.337	F	W1-1R	30	30		RIGHT TURN						1	X															
		F	W13-1	18	18		30 MPH						1														EXISTING POST WAS DAMAGED			
		F	W11-5a	30	30			6.25								1		14.75 X									X		
SIGN SUMMARY SHEET							SHEET TOTALS	48.67	0.00	0	0	0	7	0	0	7		124.75 ~~105.0~~		0	0.0	0.0	0.0	0.0					
								SF	SF	EA	EA	EA	EA	EA	EA	EA		FT		EA	LB	LB	LB	LB					
VERMONT AGENCY OF TRANSPORTATION							TOWN DIRECTIONAL TOTALS	660.5	0.0	0	2	2	107	0	0	80		1200.0		0		0.0							

PROJECT NAME: **STATEWIDE-SOUTHWEST**
PROJECT NUMBER: **STPG SIGN(47)**
FILE NAME: **z12c534TSS.xlsm**
PROJECT MANAGER: **D. BRYANT**
DESIGNED BY: **B. TOOTHAKER**
SHOREHAM WB SHEET 9
PLOT DATE: **9/15/2014**
DRAWN BY: **B. TOOTHAKER**
CHECKED **K. KERN**