DIRECTION	MILEPOINT	LOCATION CODE (SHEET 2)	SIGN CODE	WIDTH (IN)	HEIGHT (IN)	SHEETING REMARKS	SIGN LEGEND	NEW SIGNS		EXISTING SIGNS				EXIST POST		NUMBER OF NEW POSTS	SQUARE STEEL (IN)			TUBULAR STEEL Ø (IN)				SIGN FRAME REQUIRED	REMARKS	SIGN DETAIL LOCATION		
								"A"	"B"	RETAIN	SALVAGE FROM	SALVAGE TO	REMOVE	RETAIN	REMOVE		1.75 (LB / FT) 1.88	2.00 (LB / FT) 2.42	2.50 (LB / FT) 3.35	FOUNDATION	3.00 (LB / FT) 7.60	3.50 (LB / FT) 9.00	4.00 (LB / FT) 10.80	5.00 (LB / FT) 14.60			SHSM	PROJECT SHEET #	STANDARD SHEET #
SHOREHAM VT-74 WB							FY-FLUORESCENT YELLOW FYG-FLUORESCENT YELLOW GREEN																		"SHSM"-STANDARD HIGHWAY SIGNS AND MARKINGS			
WB	3.726	E	W1-6	48	24								1		X													
		E	W1-6R	48	24			8.00								2		15.75 X 15.75									X		
WB	3.726	E/F	D3-1	66	12			5.50								2		13.0 X 13.0								BASIN HARBOR RD (TH-7); FIELD LOCATE FOR VISIBILITY FROM VT74		12	
WB	3.721	H	R1-1	30	30								1		X													
		H	R1-1	30	30			6.25								1		15.0 X								BASIN HARBOR RD (TH-7)	X		
WB	3.719	E/F	D3-1	50	12			4.17								2		14.0 X 15.0								WITHERALL RD (TH-28); FIELD LOCATE FOR VISIBILITY FROM VT74		12	
WB	3.719	G	VR-017	24	30								1		X													
		G	VR-017	24	30			5.00								1		13.75 X								WITHERALL RD (TH-28)		9	
WB	3.717	F	R1-1	30	30								1		X													
		F	R1-1	30	30			6.25								1		14.25 X								WITHERALL RD (TH-28)	X		
WB	3.717	F	W1-6	48	24								1		X													
		F	W1-6L	48	24		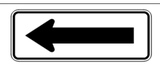	8.00								2		15.5 X 15.75									X		
WB	3.674	F	M3-4	24	12		WEST STATE						1		X													
		F	M1-5	24	24		VERMONT 74						1															
WB	3.101	G	VR-017	24	30								1		X													
							SHEET TOTALS	43.17	0.00	0	0	0	10 ~~8~~	0	0	11		~~165.0~~ 160.75		0	0.0	0.0	0.0	0.0					
								SF	SF	EA	EA	EA	EA	EA	EA	EA		FT		EA	LB	LB	LB	LB					
							TOWN DIRECTIONAL TOTALS	660.5	0.0	0	2	2	107	0	0	80		1200.0		0			0.0						

SIGN SUMMARY SHEET

VERMONT AGENCY OF TRANSPORTATION

PROJECT NAME: **STATEWIDE-SOUTHWEST**
PROJECT NUMBER: **STPG SIGN(47)**

FILE NAME: **z12c534TSS.xlsm**
PROJECT MANAGER: **D. BRYANT**
DESIGNED BY: **B. TOOTHAKER**
SHOREHAM WB SHEET 11

PLOT DATE: **9/15/2014**
DRAWN BY: **B. TOOTHAKER**
CHECKED **K. KERN**
SHEET **67** OF **107**