DIRECTION	MILEPOINT	LOCATION CODE (SHEET 2)	SIGN CODE	WIDTH (IN)	HEIGHT (IN)	SHEETING REMARKS	SIGN LEGEND	NEW SIGNS "A"	NEW SIGNS "B"	EXISTING SIGNS RETAIN	EXISTING SIGNS SALVAGE FROM	EXISTING SIGNS SALVAGE TO	EXISTING SIGNS REMOVE	EXIST POST RETAIN	EXIST POST REMOVE	NUMBER OF NEW POSTS	SQUARE STEEL (IN) 1.75 (LB / FT) 1.88	SQUARE STEEL (IN) 2.00 (LB / FT) 2.42	SQUARE STEEL (IN) 2.50 (LB / FT) 3.35	FOUNDATION	TUBULAR STEEL Ø (IN) 3.00 (LB / FT) 7.60	TUBULAR STEEL Ø (IN) 3.50 (LB / FT) 9.00	TUBULAR STEEL Ø (IN) 4.00 (LB / FT) 10.80	TUBULAR STEEL Ø (IN) 5.00 (LB / FT) 14.60	SIGN FRAME REQUIRED	REMARKS	SIGN DETAIL LOCATION SHSM	SIGN DETAIL LOCATION PROJECT SHEET #	SIGN DETAIL LOCATION STANDARD SHEET #
SHOREHAM VT-74 WB							FY-FLUORESCENT YELLOW FYG-FLUORESCENT YELLOW GREEN																			"SHSM"-STANDARD HIGHWAY SIGNS AND MARKINGS			
		F	M1-5A	24	24		ROUTE 74						1																
		F	M6-3	21	15		^UP ARROW						1																
		F	VD1-1	72	12		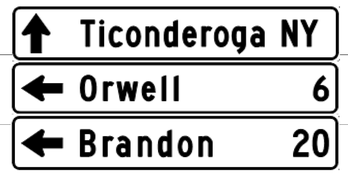	6.00									2		15.25 X 14.25									8	
		F	VD1-1a	72	12			6.00																				7	
		F	VD1-1a	72	12			6.00																				7	
WB	0.502	F	M3-2	24	12	BLK/ WHT		2.00								2		14.5 X 14.5								INSTALL 200 FT WEST OF EXISTING			E-136c
		F	M1-5	24	24	BLK/ WHT		4.00																					E-136c
		F	M6-1	21	15	BLK/ WHT		2.19																					E-136c
		F	M3-4	24	12	GRN/ WHT		2.00																					E-136b
		F	M1-5	24	24	GRN/ WHT		4.00																					E-136b
		F	M6-3	21	15	GRN/ WHT		2.19																					E-136b
WB	0.487	G	W1-7	48	24								1		X														
		G	W1-7	48	24			8.00								2		13.25 X 13.5									X		
SIGN SUMMARY SHEET							SHEET TOTALS	42.38	0.00	0	0	0	3	0	0	6		85.25 ~~90.0~~		0	0.0	0.0	0.0	0.0					
								SF	SF	EA	EA	EA	EA	EA	EA	EA		FT		EA	LB	LB	LB	LB					
VERMONT AGENCY OF TRANSPORTATION							TOWN DIRECTIONAL TOTALS	660.5	0.0	0	2	2	107	0	0	80		1200.0		0		0.0							

PROJECT NAME: STATEWIDE-SOUTHWEST
PROJECT NUMBER: STPG SIGN(47)
FILE NAME: z12c534TSS.xlsm
PROJECT MANAGER: D. BRYANT
DESIGNED BY: B. TOOTHAKER
SHOREHAM WB SHEET 14
PLOT DATE: 9/15/2014
DRAWN BY: B. TOOTHAKER
CHECKED K. KERN
SHEET 70 OF 107