DIRECTION	MILEPOINT	LOCATION CODE (SHEET 2)	SIGN CODE	WIDTH (IN)	HEIGHT (IN)	SHEETING REMARKS	SIGN LEGEND	NEW SIGNS "A"	NEW SIGNS "B"	EXISTING SIGNS RETAIN	EXISTING SIGNS SALVAGE FROM	EXISTING SIGNS SALVAGE TO	EXISTING SIGNS REMOVE	EXIST POST RETAIN	EXIST POST REMOVE	NUMBER OF NEW POSTS	SQUARE STEEL (IN) (LB / FT) 1.75 / 1.88	SQUARE STEEL (IN) (LB / FT) 2.00 / 2.42	SQUARE STEEL (IN) (LB / FT) 2.50 / 3.35	FOUNDATION	TUBULAR STEEL Ø (IN) (LB / FT) 3.00 / 7.60	TUBULAR STEEL Ø (IN) (LB / FT) 3.50 / 9.00	TUBULAR STEEL Ø (IN) (LB / FT) 4.00 / 10.80	TUBULAR STEEL Ø (IN) (LB / FT) 5.00 / 14.60	SIGN FRAME REQUIRED	REMARKS	SIGN DETAIL LOCATION SHSM	SIGN DETAIL LOCATION PROJECT SHEET #	SIGN DETAIL LOCATION STANDARD SHEET #
SHOREHAM VT-74 WB							FY-FLUORESCENT YELLOW FYG-FLUORESCENT YELLOW GREEN																			"SHSM"-STANDARD HIGHWAY SIGNS AND MARKINGS			
WB	0.104	F	M1-5A	24	24		ROUTE 74						1		X													
		F	M4-6	24	12		END						1															
WB	0.082	F	W1-3L	30	30			6.25								1		16.75 X								INSTALL 560 FT WEST OF EXISTING	X		
		F	W13-1P	18	18			2.25																			X		
WB	0.052	F	M4-6	24	12	GRN/ WHT		2.00								1		15.25 X								INSTALL 275 FT WEST OF EXISTING	X		
		F	M1-5	24	24	GRN/ WHT		4.00																				E-136b
WB	0.052	F	VR-038	24	18			3.00								1		13.0 X								INSTALL ADJACENT TO AND RIGHT OF ROUTE MARKER ASSEMBLY		9	
WB	0.031	F	W1-6L	48	24		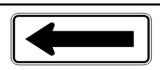	8.00								2		12.25 X 12.5								INSTALL 110 FT WEST OF PROPOSED ROUTE SIGN - REQUIRES VEGETATION CLEARING	X		
WB	0.029	F	W1-6	48	24		<=== LEFT LARGE ARROW						1		X													
WB	0.029	E	W1-6R	48	24			8.00								2		12.5 X 12.5								INSTALL AT LEAST 10 FT EAST OF LARGE LEFT ARROW	X		

SIGN SUMMARY SHEET

VERMONT AGENCY OF TRANSPORTATION

SHEET TOTALS	33.50	0.00	0	0	0	3	0	0	7	94.75 ~~105.0~~	0	0.0	0.0	0.0	0.0
	SF	SF	EA	EA	EA	EA	EA	EA	EA	FT	EA	LB	LB	LB	LB
TOWN DIRECTIONAL TOTALS	660.46 ~~660.5~~	0.0	0	2	9 ~~2~~	121 ~~107~~	0	0	80	1210.75 ~~1200.0~~	0	0.0			

PROJECT NAME: **STATEWIDE-SOUTHWEST**
PROJECT NUMBER: **STPG SIGN(47)**
FILE NAME: **z12c534TSS.xlsm**
PROJECT MANAGER: **D. BRYANT**
DESIGNED BY: **B. TOOTHAKER**
SHOREHAM WB SHEET 16
PLOT DATE: **9/15/2014**
DRAWN BY: **B. TOOTHAKER**
CHECKED **K. KERN**
SHEET **72** OF **107**