DIRECTION	MILEPOINT	LOCATION CODE (SHEET 2)	SIGN CODE	WIDTH (IN)	HEIGHT (IN)	SHEETING REMARKS	SIGN LEGEND	NEW SIGNS "A"	NEW SIGNS "B"	EXISTING SIGNS RETAIN	EXISTING SIGNS SALVAGE FROM	EXISTING SIGNS SALVAGE TO	EXISTING SIGNS REMOVE	EXIST POST RETAIN	EXIST POST REMOVE	NUMBER OF NEW POSTS	SQUARE STEEL (IN) (LB / FT) 1.75 / 1.88	SQUARE STEEL (IN) (LB / FT) 2.00 / 2.42	SQUARE STEEL (IN) (LB / FT) 2.50 / 3.35	TUBULAR STEEL Ø (IN) FOUNDATION	TUBULAR STEEL Ø (IN) (LB / FT) 3.00 / 7.60	TUBULAR STEEL Ø (IN) (LB / FT) 3.50 / 9.00	TUBULAR STEEL Ø (IN) (LB / FT) 4.00 / 10.80	TUBULAR STEEL Ø (IN) (LB / FT) 5.00 / 14.60	SIGN FRAME REQUIRED	REMARKS	SIGN DETAIL LOCATION SHSM	SIGN DETAIL LOCATION PROJECT SHEET #	SIGN DETAIL LOCATION STANDARD SHEET #
ADDISON VT-125 WB							FY-FLUORESCENT YELLOW FYG-FLUORESCENT YELLOW GREEN																			"SHSM"-STANDARD HIGHWAY SIGNS AND MARKINGS			
WB	1.847	F	W1-2L	30	30		LEFT CURVE						~~1~~		X											COULD NOT LOCATE			
WB	1.814	G	VR-017	24	30								1		X														
		E/F	D3-1	UNK.	UNK.		TOWN LINE RD (TH-25)						1																
		G	VR-017	24	30			5.00								1		12.5 X							TOWN LINE RD (TH-25)		9	
WB	1.808	H	R1-1	30	30								~~1~~	X												NO EXISTING STOP SIGN			
		H	R1-1	30	30			6.25								1		13.5 X							TOWN LINE RD (TH-25)	X		
WB	1.808	E/F	D3-1	54 54 54	6 12 6		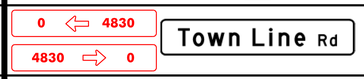	4.50								2		11.75 X 11.25							TOWN LINE RD (TH-25); FIELD LOCATE FOR VISIBILITY FROM VT125		12	
WB	1.649	F	W3-5	36	36		SPEED REDUCTION SPEED LIMIT 40			1				X														
WB	1.562	F	R2-1	24	30								1	X															
		F	R2-1	30	36			7.50																				X	
WB	1.465	F	W1-5R	30	30		WINDING ROAD			1				X												SIGNS DAMAGED			
		F	W7-3A	24	18		NEXT 1 MILE			1																			
WB	1.433	F	W1-1R	30	30		RIGHT TURN						1		X														
		F	W13-1	18	18		25 MPH						1																
WB	1.413	F	W1-1R	30	30			6.25								1		14.75 X							INSTALL 100 FT WEST OF EXISTING	X		
SIGN SUMMARY SHEET							SHEET TOTALS	~~34.0~~ 29.50	0.00	3	0	0	~~5~~ 7	0	0	4		~~63.75~~ 60.0		0	0.0	0.0	0.0	0.0				
								SF	SF	EA	EA	EA	EA	EA	EA	EA		FT		EA	LB	LB	LB	LB				
VERMONT AGENCY OF TRANSPORTATION							TOWN DIRECTIONAL TOTALS	107.3	0.0	24	0	0	21	0	0	13		195.0		0	0.0							

PROJECT NAME: **STATEWIDE-SOUTHWEST**
PROJECT NUMBER: **STPG SIGN(47)**
FILE NAME: **z12c534TSS.xlsm**
PROJECT MANAGER: **D. BRYANT**
DESIGNED BY: **B. TOOTHAKER**
ADDISON WB SHEET 1
PLOT DATE: **9/15/2014**
DRAWN BY: **B. TOOTHAKER**
CHECKED **K. KERN**
SHEET **76** OF **107**