DIRECTION	MILEPOINT	LOCATION CODE (SHEET 2)	SIGN CODE	WIDTH (IN)	HEIGHT (IN)	SHEETING REMARKS	SIGN LEGEND	NEW SIGNS "A"	NEW SIGNS "B"	EXISTING SIGNS RETAIN	EXISTING SIGNS SALVAGE FROM	EXISTING SIGNS SALVAGE TO	EXISTING SIGNS REMOVE	EXIST POST RETAIN	EXIST POST REMOVE	NUMBER OF NEW POSTS	SQUARE STEEL (IN) (LB / FT) 1.75 / 1.88	SQUARE STEEL (IN) (LB / FT) 2.00 / 2.42	SQUARE STEEL (IN) (LB / FT) 2.50 / 3.35	TUBULAR STEEL Ø (IN) FOUNDATION	TUBULAR STEEL Ø (IN) (LB / FT) 3.00 / 7.60	TUBULAR STEEL Ø (IN) (LB / FT) 3.50 / 9.00	TUBULAR STEEL Ø (IN) (LB / FT) 4.00 / 10.80	TUBULAR STEEL Ø (IN) (LB / FT) 5.00 / 14.60	SIGN FRAME REQUIRED	REMARKS	SIGN DETAIL LOCATION SHSM	SIGN DETAIL LOCATION PROJECT SHEET #	SIGN DETAIL LOCATION STANDARD SHEET #
BRIDPORT VT-125 WB							FY-FLUORESCENT YELLOW FYG-FLUORESCENT YELLOW GREEN																			"SHSM"-STANDARD HIGHWAY SIGNS AND MARKINGS			
WB	5.018	F	W11-5	30	30								1	X														
		F	W11-5	30	30			6.25																			X		
WB	4.944	E/F	D3-1	UNK.	UNK.		E HUTCHINSON RD (TH-20)						1	X														
		G	UNK.	UNK.	UNK.		CLASS 4 ROAD ENTER AT OWN RISK			1																TRIM EXTRA POST ONCE STREET NAME SIGN REMOVED			
WB	4.940	E/F	D3-1	66	12		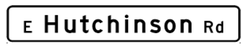	5.50								2		12.5 X 12.5								E HUTCHINSON RD (TH-20); FIELD LOCATE FOR VISIBILITY FROM VT-125		13	
WB	3.861	G	VR-017	24	30			5.00								1		12.5 X								FROSTY LN (TH-4)		9	
WB	3.855	H	R1-1	30	30		MM PLAQUE 0386				I		1 I		X													
		E/F	D3-1	40	12			3.33								1		13.75 X								FROSTY LN (TH-4); MOUNT TO STOP SIGN WITH BRACKET		13	
		H	R1-1	30	30			6.25				I														FROSTY LN (TH-4)	X		
WB	3.557	F	W11-5	30	30			6.25								1		14.5 X								INSTALL 115 FT EAST OF EXISTING	X		
WB	3.535	F	W11-5	30	30		FARM MACHINERY SYMBOL						1		X			13.5										
		F	W1-2MR	30	30		MODIFIED RIGHT CURVE						1															
		F	VW-092P	24	18		UNSAFE TO PASS PLAQUE						1															
WB	3.519	F	W1-10R	36	36			9.00								2		15.5 X 16.0								INSTALL 85 FT WEST OF EXISTING	X		
		F	VW-092P	24	18			3.00																				9	
SIGN SUMMARY SHEET							SHEET TOTALS	44.58	0.00	1	I 0	I 0	7 6	0	0	7		97.25 105.0		0	0.0	0.0	0.0	0.0					
								SF	SF	EA	EA	EA	EA	EA	EA	EA		FT		EA	LB	LB	LB	LB					
VERMONT AGENCY OF TRANSPORTATION							TOWN DIRECTIONAL TOTALS	235.1	0.0	6	2	2	44	0	0	26		390.0		0	0.0								

PROJECT NAME: **STATEWIDE-SOUTHWEST**
PROJECT NUMBER: **STPG SIGN(47)**

FILE NAME: **z12c534TSS.xlsm**
PROJECT MANAGER: **D. BRYANT**
DESIGNED BY: **B. TOOTHAKER**
BRIDPORT WB SHEET 5

PLOT DATE: **9/15/2014**
DRAWN BY: **B. TOOTHAKER**
CHECKED **K. KERN**
SHEET **93** OF **107**