DIRECTION	MILEPOINT	LOCATION CODE (SHEET 2)	SIGN CODE	WIDTH (IN)	HEIGHT (IN)	SHEETING REMARKS	SIGN LEGEND	NEW SIGNS "A"	NEW SIGNS "B"	EXISTING SIGNS RETAIN	EXISTING SIGNS SALVAGE FROM	EXISTING SIGNS SALVAGE TO	EXISTING SIGNS REMOVE	EXIST POST RETAIN	EXIST POST REMOVE	NUMBER OF NEW POSTS	SQUARE STEEL (IN) (LB / FT) 1.75 / 1.88	SQUARE STEEL (IN) (LB / FT) 2.00 / 2.42	SQUARE STEEL (IN) (LB / FT) 2.50 / 3.35	TUBULAR STEEL Ø (IN) FOUNDATION	TUBULAR STEEL Ø (IN) (LB / FT) 3.00 / 7.60	TUBULAR STEEL Ø (IN) (LB / FT) 3.50 / 9.00	TUBULAR STEEL Ø (IN) (LB / FT) 4.00 / 10.80	TUBULAR STEEL Ø (IN) (LB / FT) 5.00 / 14.60	SIGN FRAME REQUIRED	REMARKS	SIGN DETAIL LOCATION SHSM	SIGN DETAIL LOCATION PROJECT SHEET #	SIGN DETAIL LOCATION STANDARD SHEET #
CORNWALL VT-125 EB							FY-FLUORESCENT YELLOW FYG-FLUORESCENT YELLOW GREEN																			"SHSM"-STANDARD HIGHWAY SIGNS AND MARKINGS			
EB	1.851	A	W1-10L	30	30			6.25								1		16.0 X								INSTALL 450 FT EAST OF EXISTING	X		
		A	W13-1P	18	18			2.25																			X		
EB	1.872	B	W1-6	48	24								1		X														
		B	W1-6R	48	24			8.00								2		12.75 X 13.75									X		
EB	1.878	C	VR-017	24	30			5.00								1		13.0 X								~~HAMLIN~~ HAMBLIN RD (TH-14)		9	
EB	1.883	A	W1-6	48	24								1		X														
		A	W1-6L	48	24			8.00								2		11.75 X 12.25									X		
EB	1.884	D	R1-1	30	30			3.50					1 ~~1~~	X															
		A/B	D3-1	42	12		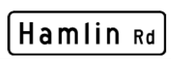	3.50																		HAMBLIN ~~HAMLIN~~ RD (TH-14); MOUNT TO STOP SIGN WITH BRACKET SIGN SPELLED WRONG		13	
		D	R1-1	30	30			6.25																		HAMBLIN ~~HAMLIN~~ RD (TH-14)	X		
EB	1.892	B	W1-6	48	24								1		X														
		B	W1-6R	48	24			8.00								2		13.0 X 12.25									X		
EB	1.905	C	VR-017	24	30			5.00								1		13.5 X								HAMBLIN ~~HAMLIN~~ RD (TH-14)		9	
EB	1.911	A/B	D3-1	UNK.	UNK.								1	X															
		D	R1-1	24	24			3.50					1 ~~1~~																
SIGN SUMMARY SHEET							SHEET TOTALS	~~59.25~~ ~~52.25~~	0.00	0	0	0	~~8~~ ~~6~~	0	0	9		~~118.25~~ ~~135.0~~		0	0.0	0.0	0.0	0.0					
								SF	SF	EA	EA	EA	EA	EA	EA	EA		FT		EA	LB	LB	LB	LB					
VERMONT AGENCY OF TRANSPORTATION							TOWN DIRECTIONAL TOTALS	192.7	0.0	23	1	1	32	0	0	35		525.0		0	0.0								

PROJECT NAME: **STATEWIDE - SOUTHWEST**
PROJECT NUMBER: **STPG (SIGN 47)**
FILE NAME: **z12c534TSS.xlsm**
PROJECT MANAGER: **D. BRYANT**
DESIGNED BY: **B. TOOTHAKER**
CORNWALL EB SHEET 3
PLOT DATE: **9/15/2014**
DRAWN BY: **B. TOOTHAKER**
CHECKED **K. KERN**
SHEET **98** OF **107**