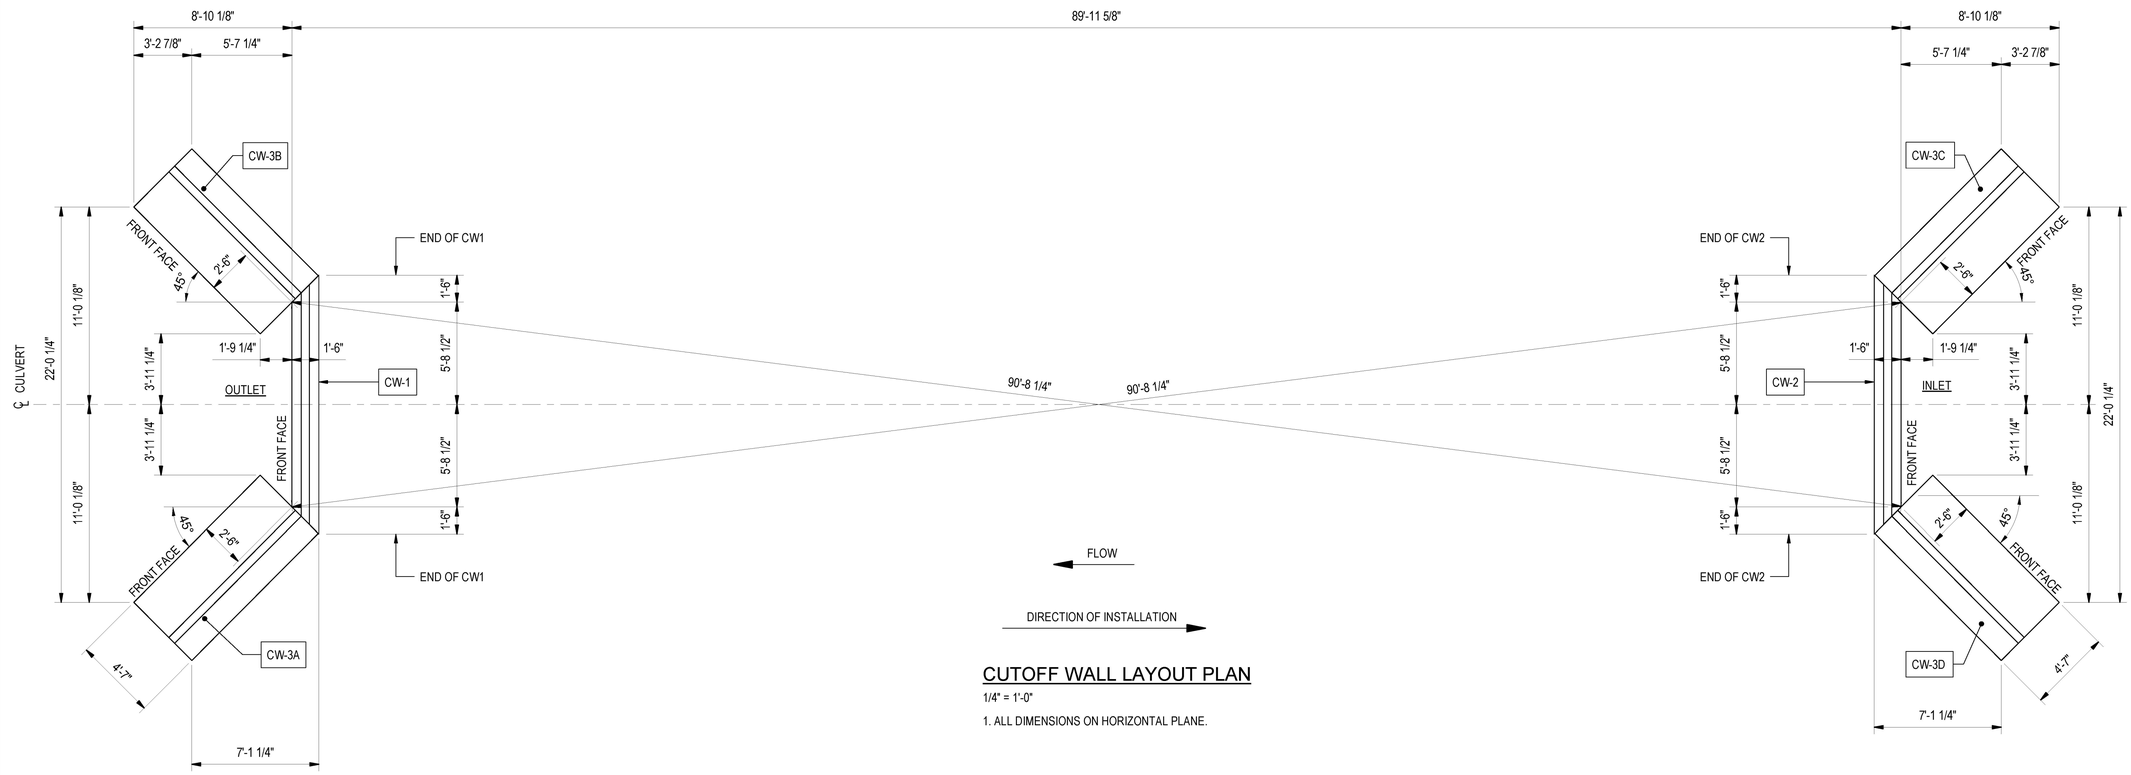

CUTOFF WALL LAYOUT PLAN

1/4" = 1'-0"

1. ALL DIMENSIONS ON HORIZONTAL PLANE.

Vermont Agency of Transportation

RECEIVED

St_Albans_Box_Culvert_Drawings submittal 05_17_17.pdf

CK'D BY J. B. McCarthy OK'D BY J. B. McCarthy

May 17, 2017

RESUBMIT No Approved

BY J. B. McCarthy DATE 05/18/17

STATE OF VERMONT
TIMOTHY W. DALL
No. 8096
Structural II
LICENSED PROFESSIONAL ENGINEER

Stamp

No.	Description	Date

ENGINEERING VENTURES PC
208 Flynn Avenue, Suite 2A, Burlington, VT 05401
tel. 802-863-6225 fax. 802-863-6306
85 Mechanic Street, Suite B2-2, Lebanon, NH 03766
tel. 603-442-9333 fax. 603-442-9331
www.engineeringventures.com

CAMP PRECAST CONCRETE
78 PRECAST ROAD
HILTON, VT 05453
PHONE: (802) 893-1501
FAX: (802) 893-1542

Sheet Title: CUTOFF WALL LAYOUT PLAN

Project Title: TOWN OF ST. ALBANS
VT ROUTE 104, CULVERT #19
ST. ALBANS, VERMONT

Designed By:	CPA
Checked By:	TWD
Drawn	JTM
Scale:	AS NOTED
Date:	04/04/2017

EV Project #17022.02