


LAKE CHAMPLAIN

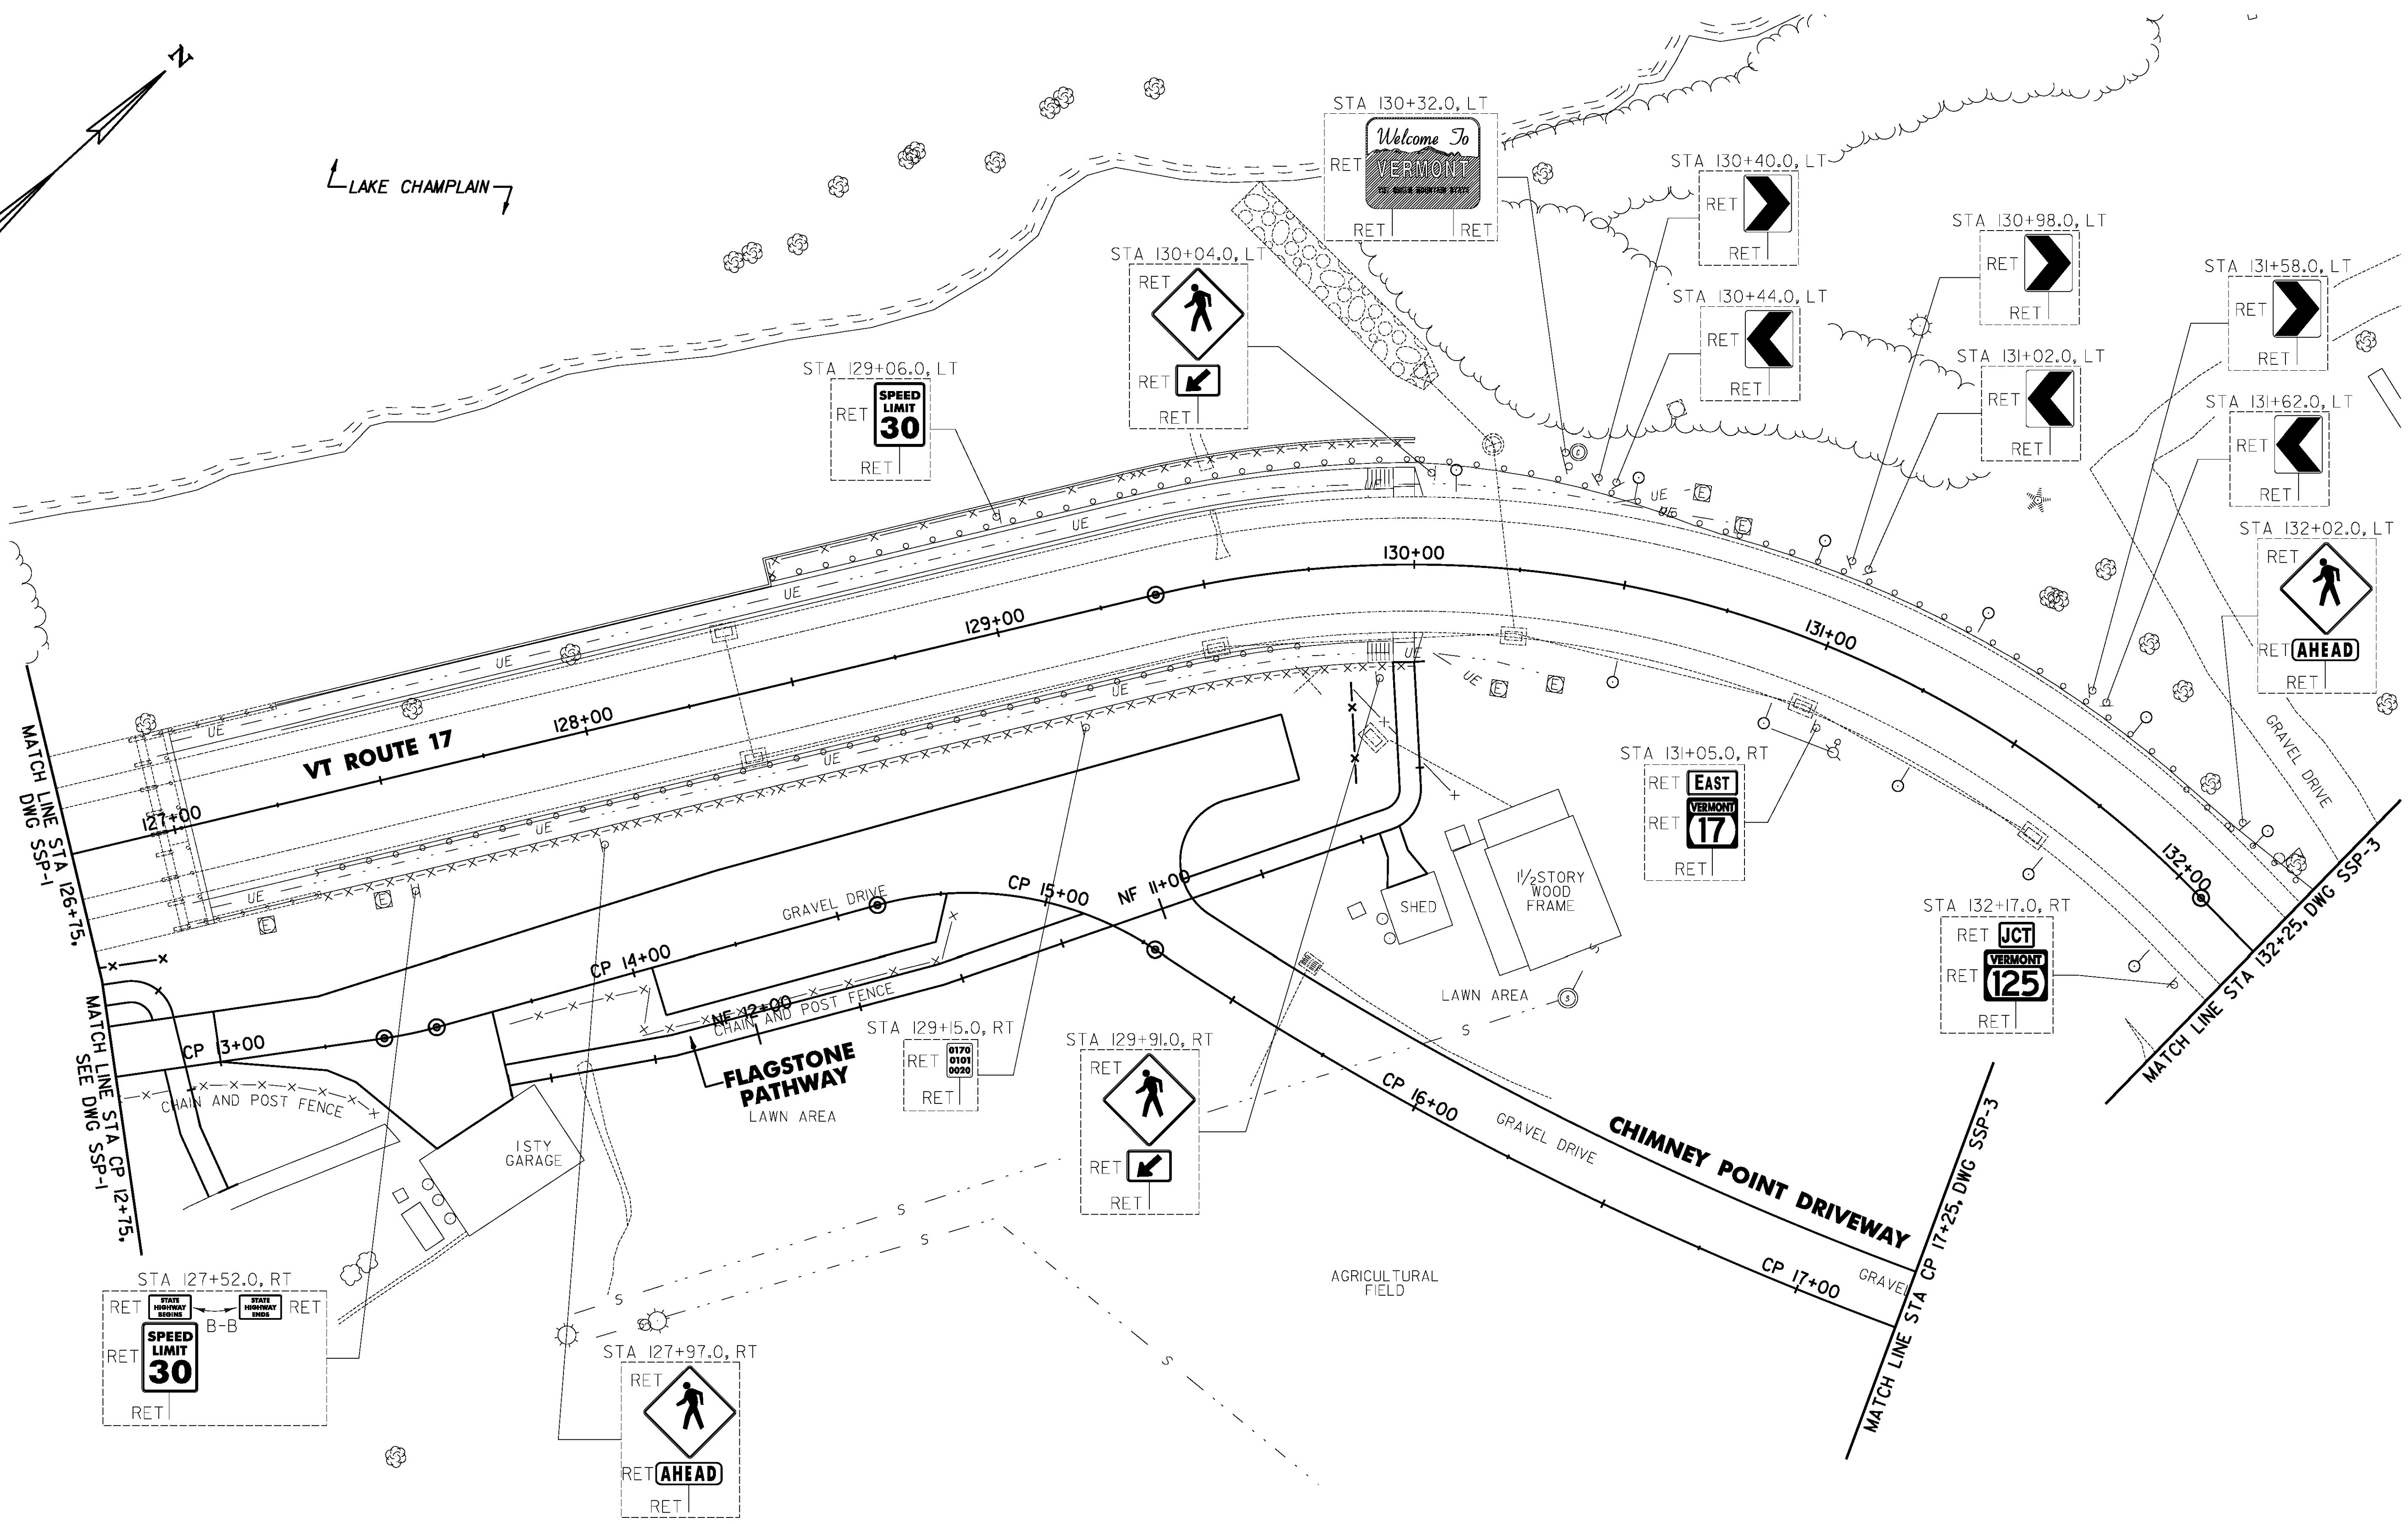



MATCH LINE STA CP 12+75, SEE DWG SSP-1

MATCH LINE STA 132+25, DWG SSP-3

MATCH LINE STA CP 17+25, DWG SSP-3

FILE NAME = I:\212\30\ACADD\MSTN\212E008_ssp_02.dgn
DATE/TIME = 7/12/2012
USER = 4666

SIGN LEGEND
R = REMOVE
S = SALVAGE
N = NEW
RET = RETAIN
B-B = BACK TO BACK
EXISTING =
NEW =

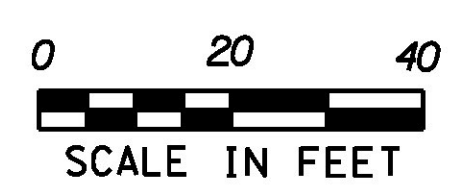

SIGNING AND STRIPING SHEET #2	PROJECT NAME: LAKE CHAMPLAIN SITE RESTORATION
	PROJECT NUMBER: STP 032-1(18)
	FILE NAME: z12E008_ssp_02.dgn
	DWG. NO.: SSP-2
	PLOT DATE: 7/12/2012
	DRAWN BY: W.G.P.
	CHECKED BY: D.E.G.
	SHEET 50 OF 100