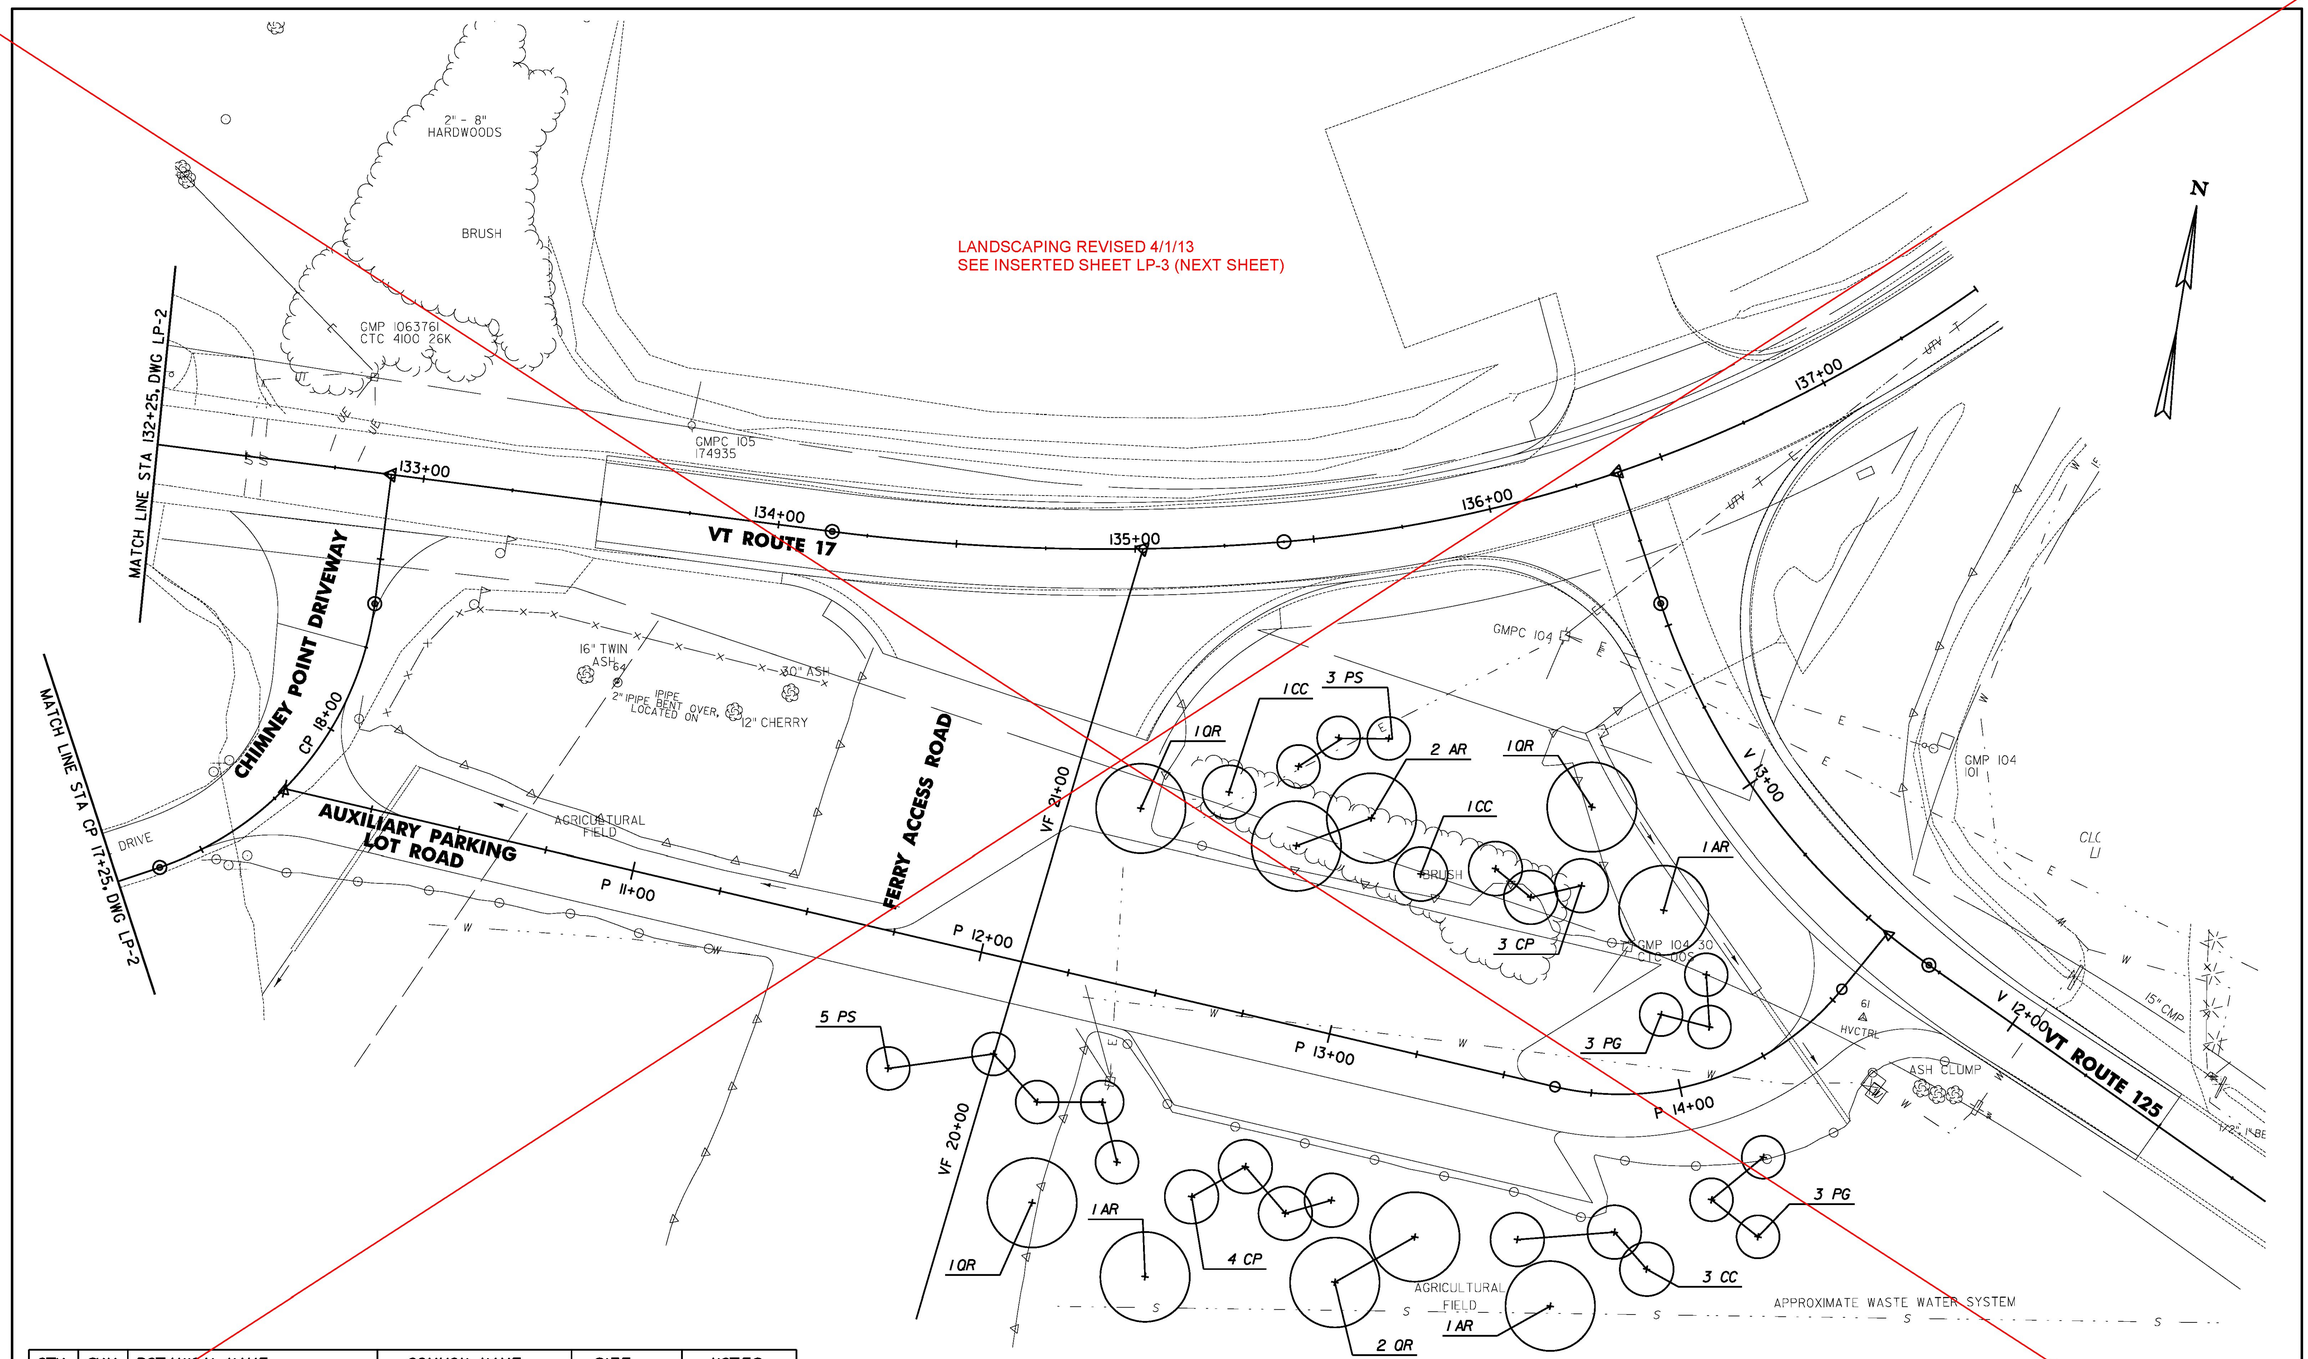

QTY.	SYM.	BOTANICAL NAME	COMMON NAME	SIZE	NOTES
6	PG	PICEA GLAUCA	SPRUCE	7' - 8' HT.	B&B
5	AR	ACER RUBRUM "OCTOBER GLORY"	RED MAPLE	2" - 2½" CAL.	B&B
7	CP	CRATAEGUS PHAENOPYRUM	WASHINGTON HAWTHORNE	1¾" - 2" CAL.	B&B
5	QR	QUERCUS RUBRA	RED OAK	2" - 2½" CAL.	B&B
5	CC	CERCIS CANADENSIS	EASTERN REDBUD	6' - 7' HT.	B&B
8	PS	PINUS STROBUS	WHITE PINE	7' - 8' HT.	B&B

LANDSCAPING PLAN SHEET #3

PROJECT NAME: LAKE CHAMPLAIN SITE RESTORATION
PROJECT NUMBER: STP 032-1(18)

FILE NAME: z12E008_lsp_03.dgn
PROJECT LEADER: D.E.G.
DESIGNED BY: B.T.H.
DWG. NO.: LP-3

PLOT DATE: 7/12/2012
DRAWN BY: W.G.P.
CHECKED BY: D.E.G.
SHEET 73 OF 100

FILE NAME = U:\20330\CADD\MSTN\z12E008_lsp_03.dgn
DATE/TIME = 7/12/2012
USER = 4066