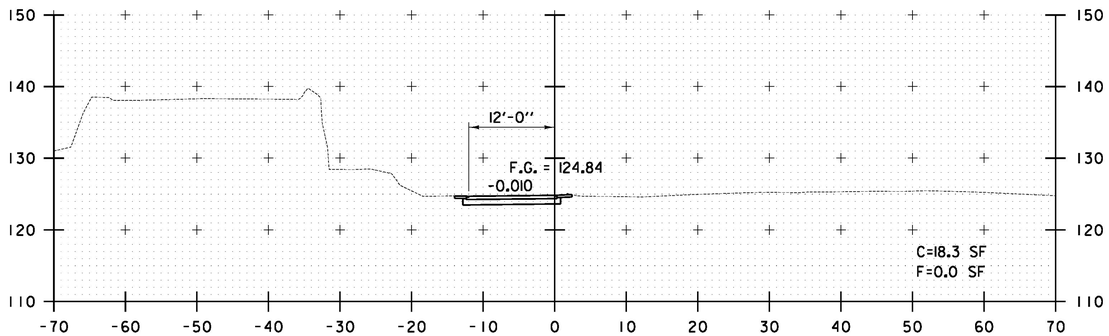

CP 13+00

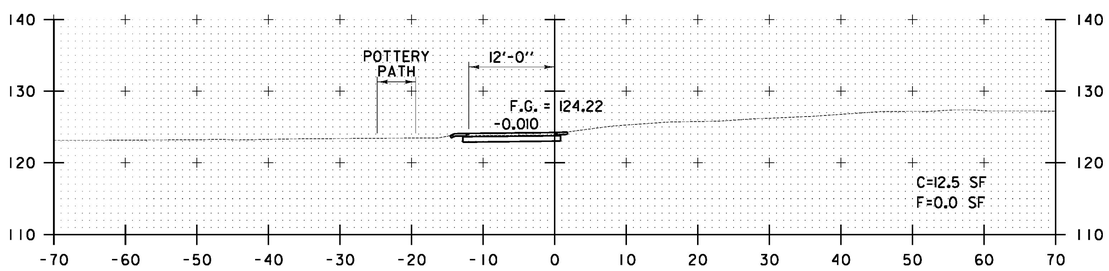

CP 12+50

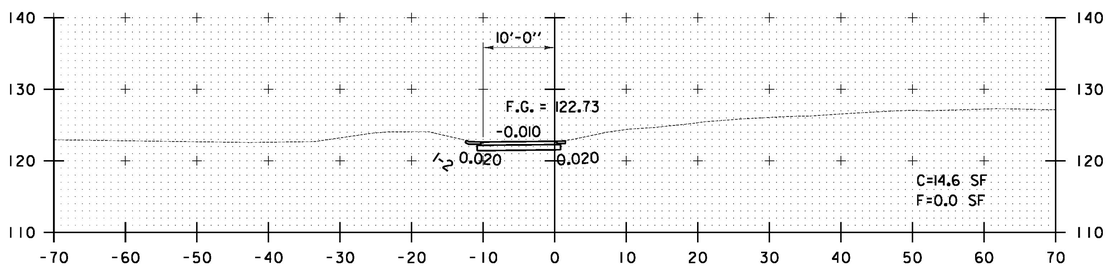

CP 12+25

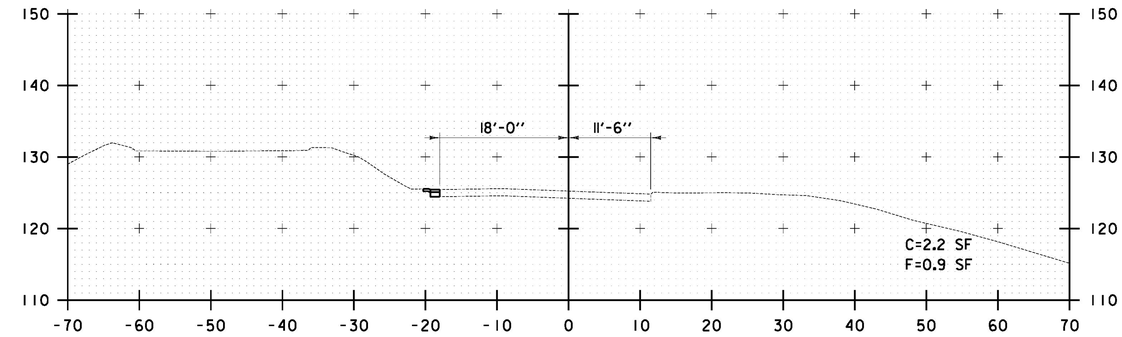

CP 14+50

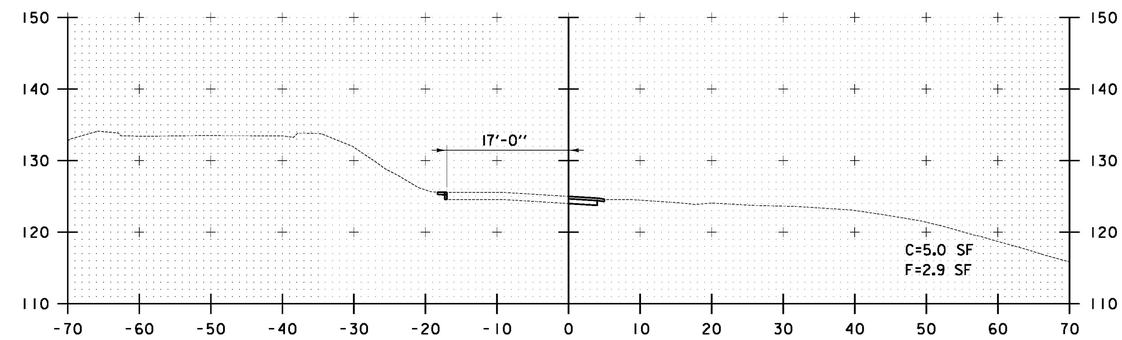

CP 14+00

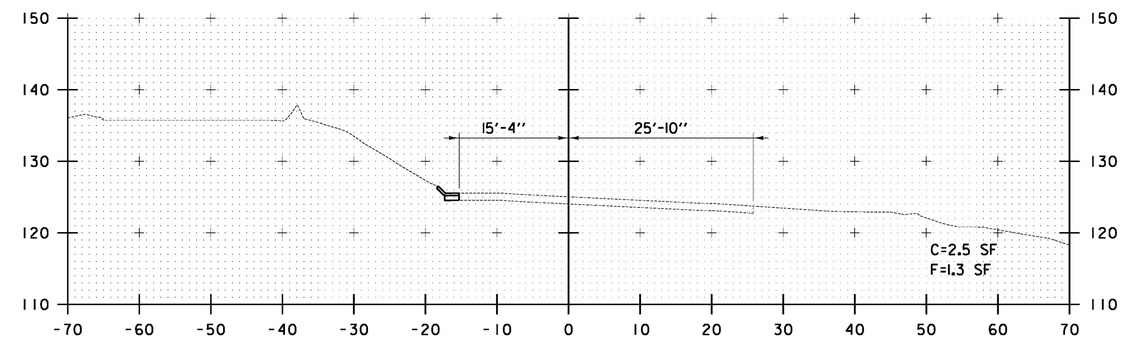

CP 13+50

0 10 20
SCALE IN FEET

STA. CP 12+25 TO STA. CP 14+50

FILE NAME = U:\20330\CADD\MSTN\z12E008_xsec_01.dgn
DATE/TIME = 7/12/2012
USER = 4066

CROSS SECTION SHEET #2	PROJECT NAME: LAKE CHAMPLAIN SITE RESTORATION PROJECT NUMBER: STP 032-1(18)
	FILE NAME: z12E008_xsec_01.dgn PROJECT LEADER: D.E.G. DESIGNED BY: B.T.H. DWG. NO.: XS-2 PLOT DATE: 7/12/2012 DRAWN BY: W.G.P. CHECKED BY: D.E.G. SHEET 76 OF 100