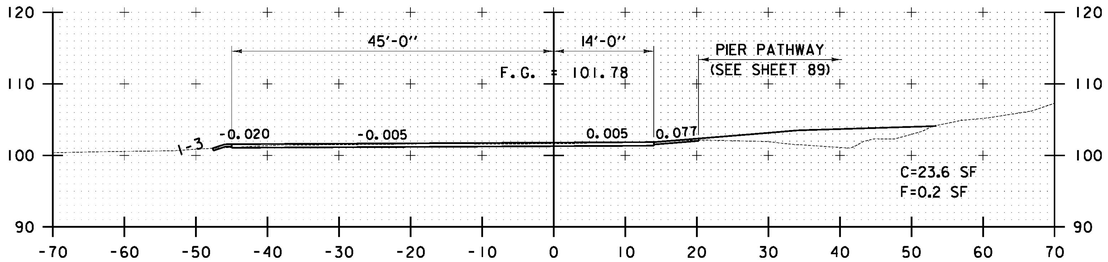

VB 4+50

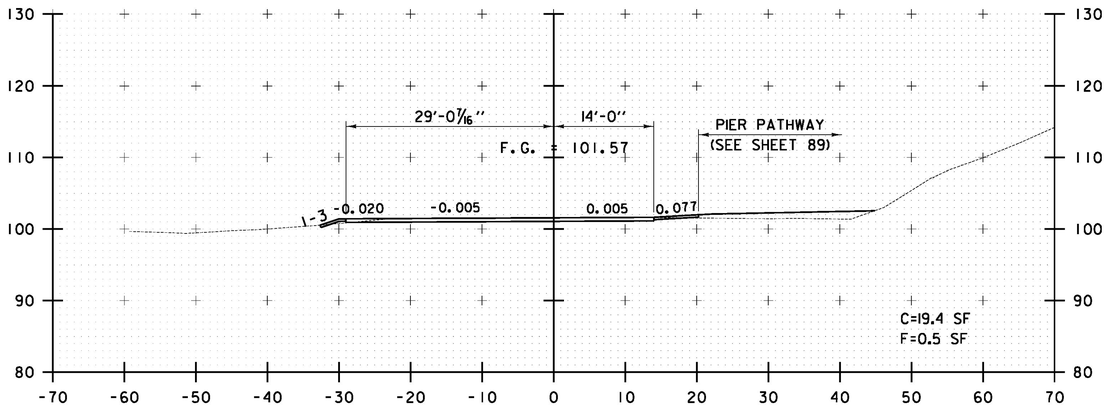

VB 4+00

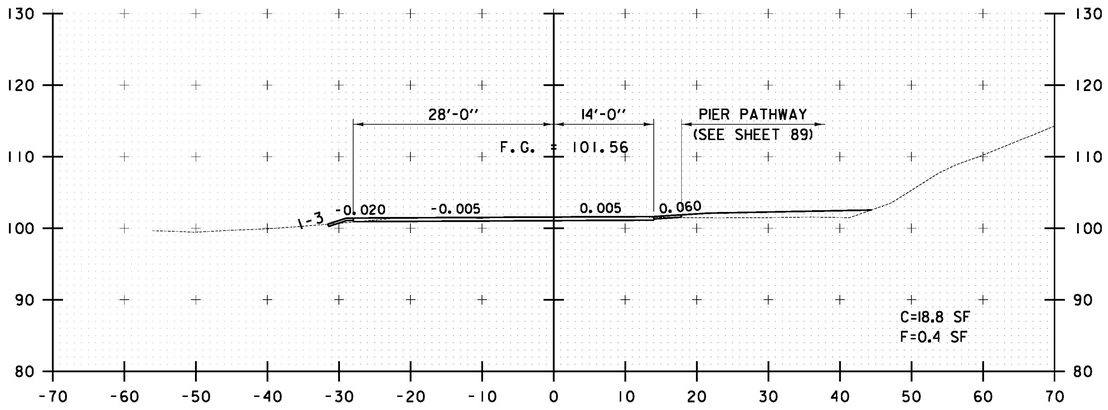

VB 3+98

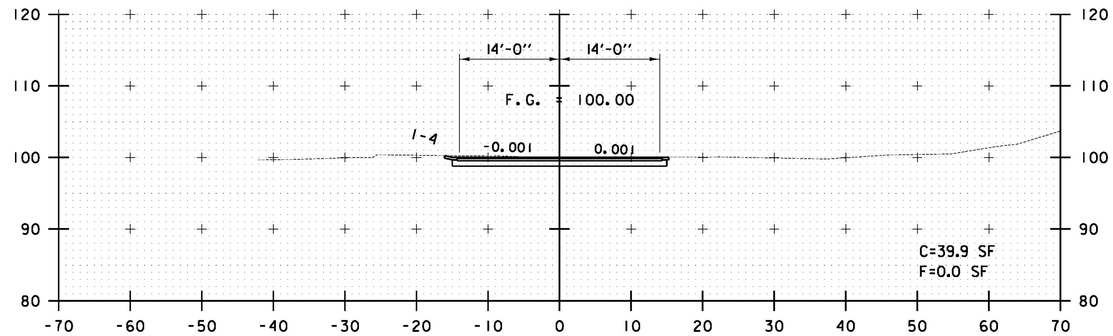

VB 5+75

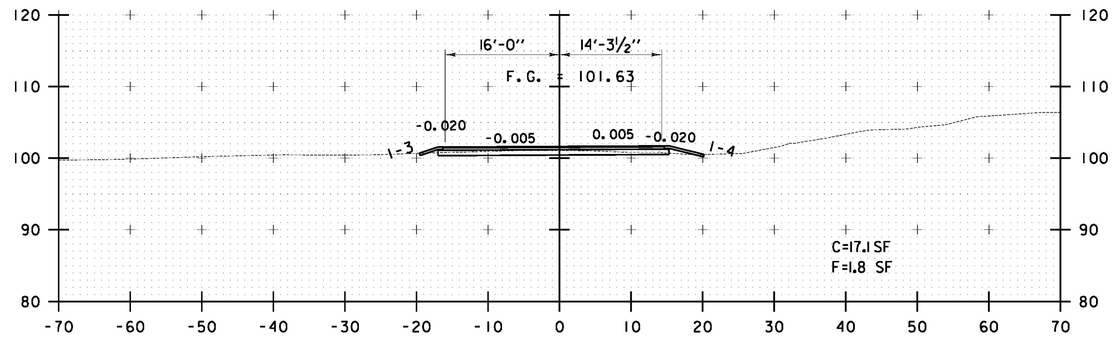

VB 5+50

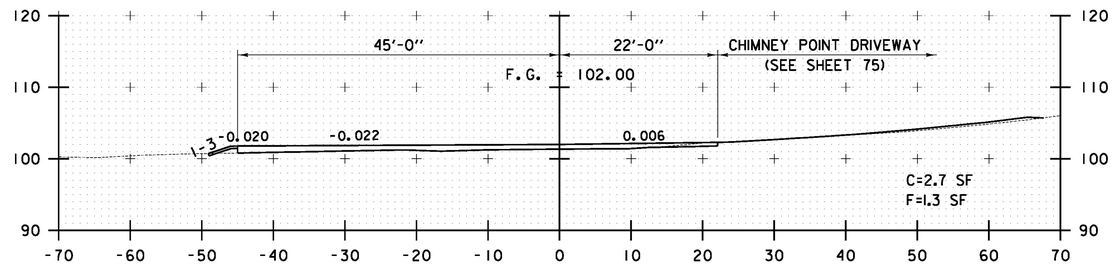

VB 5+00

0 10 20
SCALE IN FEET

STA. VB 3+98 TO STA. VB 5+75

FILE NAME = U:\20330\CADD\MSTN\z12E008_xsec_04.dgn
DATE/TIME = 7/12/2012
USER = 4066

CROSS SECTION SHEET #10	PROJECT NAME: LAKE CHAMPLAIN SITE RESTORATION PROJECT NUMBER: STP 032-1(18)
	FILE NAME: z12E008_xsec_04.dgn — PLOT DATE: 7/12/2012 PROJECT LEADER: D.E.G. — DRAWN BY: W.G.P. DESIGNED BY: B.T.H. — CHECKED BY: D.E.G. DWG. NO.: XS-10 — SHEET 84 OF 100