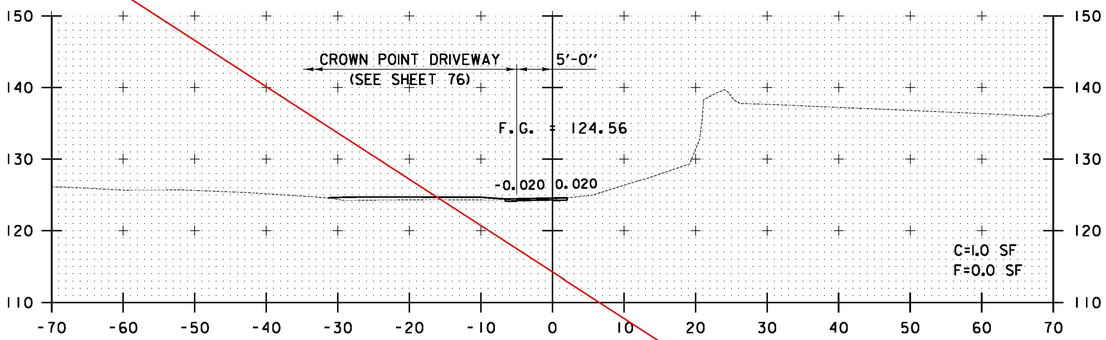

M 1+50

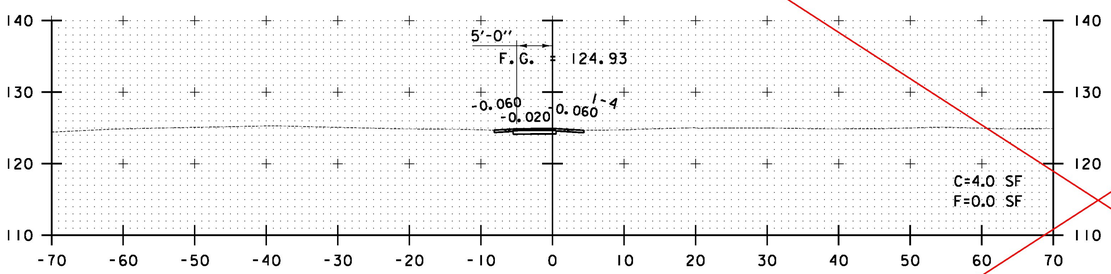

M 1+25

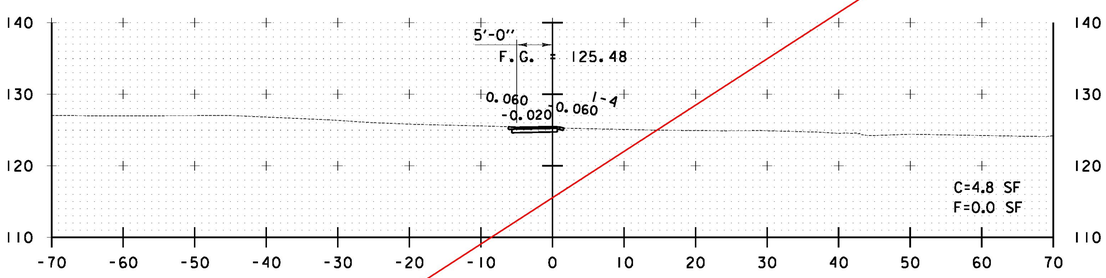

M 1+00

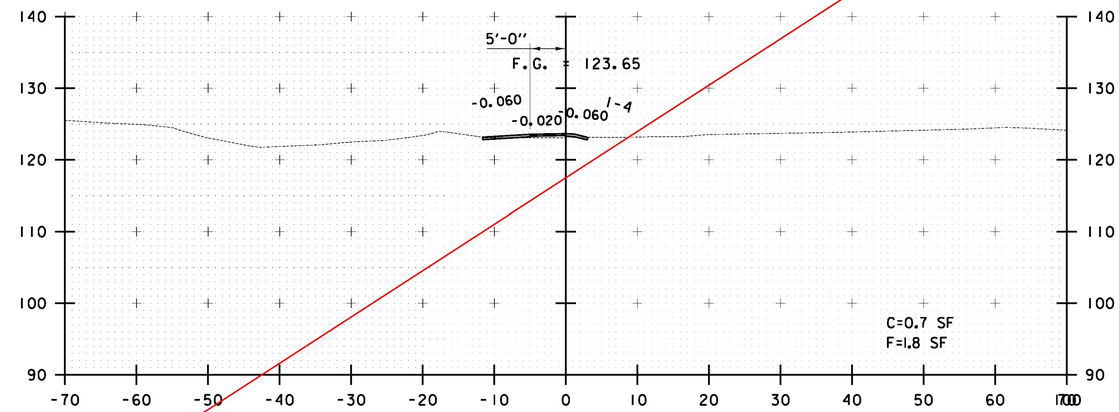

M 2+00

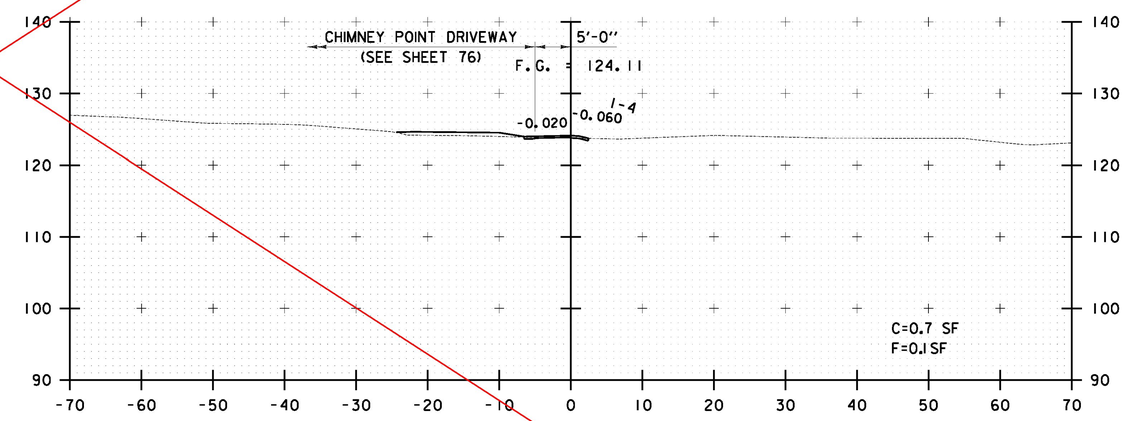

M 1+75

SEE REVISED SHEET 87A

0 10 20
SCALE IN FEET

STA. M 1+00 TO STA. M 2+00

FILE NAME = U:\20330\CADD\MSTN\z12E008_xsec_06.dgn
DATE/TIME = 7/12/2012
USER = 4206

CROSS SECTION SHEET #13	PROJECT NAME: LAKE CHAMPLAIN SITE RESTORATION PROJECT NUMBER: STP 032-1(18)
	FILE NAME: z12E008_xsec_06.dgn PROJECT LEADER: D.E.G. DESIGNED BY: B.T.H. DWG. NO.: XS-13
	PLOT DATE: 7/12/2012 DRAWN BY: W.G.P. CHECKED BY: D.E.G. SHEET 87 OF 100