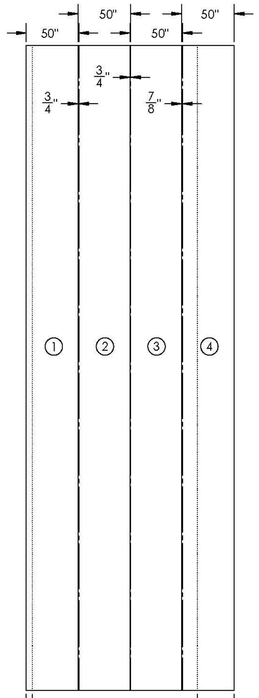

1 FLANGE WIDTH 6" TYP

VERT. SIDE HT. 35" TYP 1

PLY # 1 - C-VEIL

PLAN VIEW OF "UNFOLDED" HULL

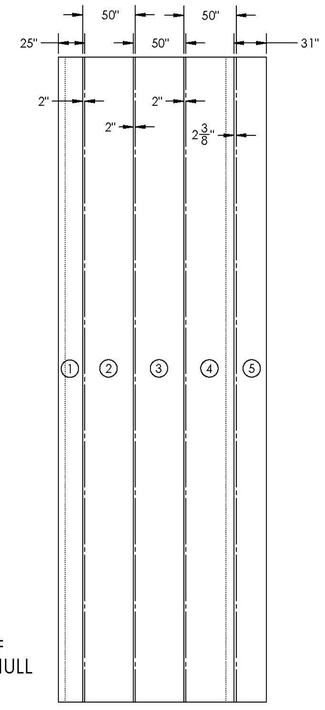

PLY # 2 - 4008

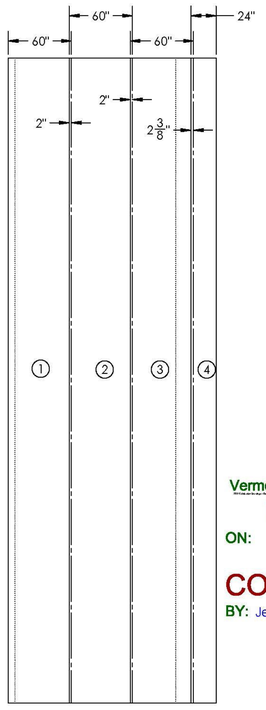

1 **PLY # 3 - 54 oz**

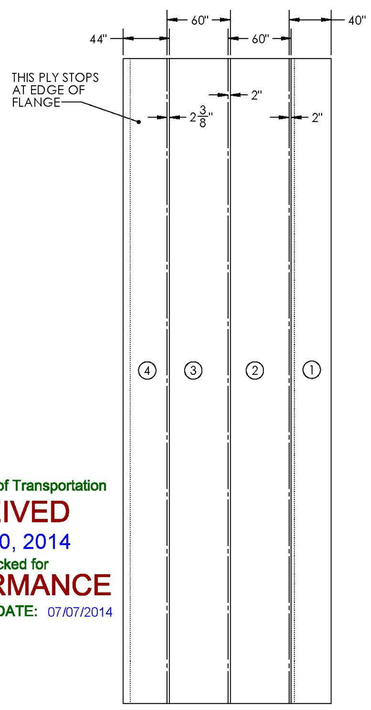

1 **PLY # 4 - 54 oz**

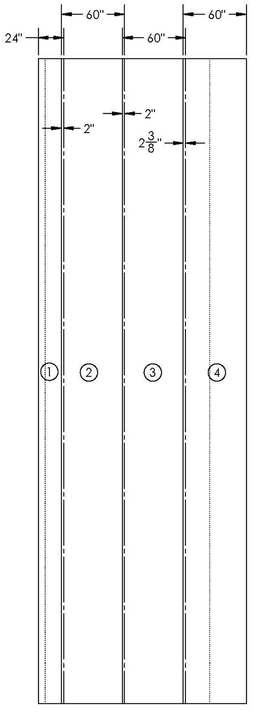

1 **PLY # 5 - 54 oz**

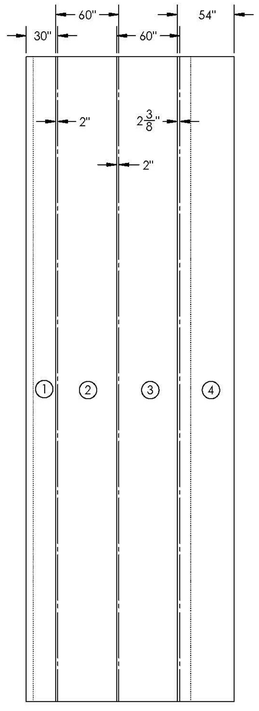

1 **PLY # 6 - 54 oz**

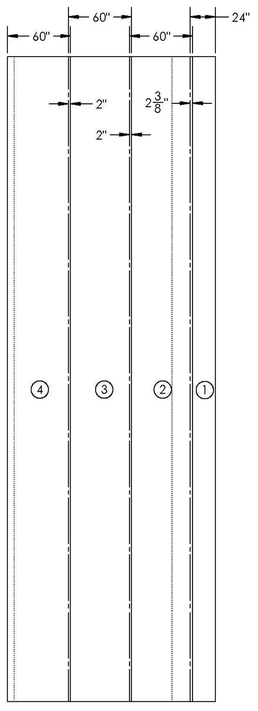

1 **PLY # 7 - 54 oz**

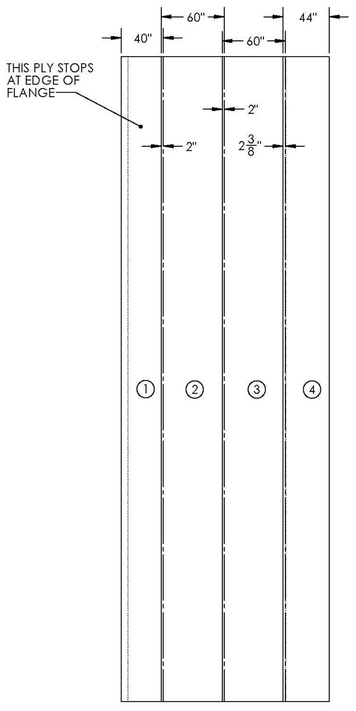

1 **PLY #8 - 54 oz**

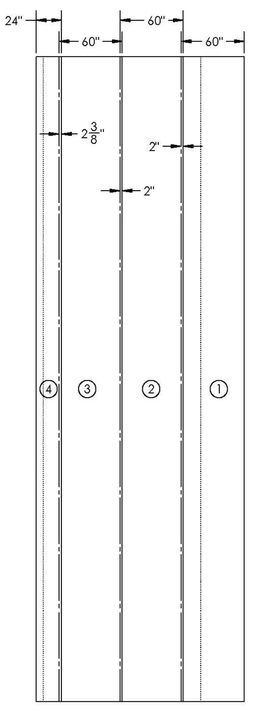

1 **PLY # 9 - 54 oz**

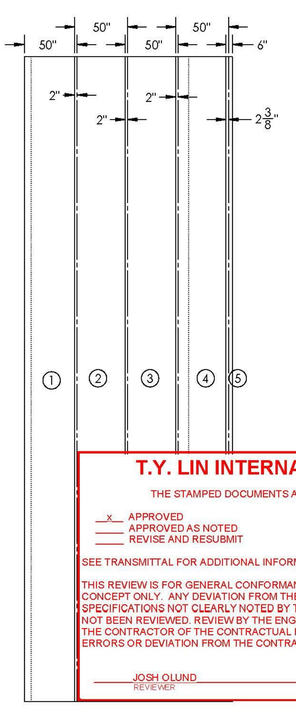

PLY # 10 - 4008

Vermont Agency of Transportation
RECEIVED
ON: June 30, 2014
and Checked for
CONFORMANCE
BY: Jennifer Fitch DATE: 07/07/2014

T.Y. LIN INTERNATIONAL

THE STAMPED DOCUMENTS ARE HEREBY:

__x__ APPROVED
_____ APPROVED AS NOTED
_____ REVISE AND RESUBMIT

SEE TRANSMITTAL FOR ADDITIONAL INFORMATION AS APPLICABLE.

THIS REVIEW IS FOR GENERAL CONFORMANCE WITH DESIGN CONCEPT ONLY. ANY DEVIATION FROM THE PLANS OR SPECIFICATIONS NOT CLEARLY NOTED BY THE CONTRACTOR HAS NOT BEEN REVIEWED. REVIEW BY THE ENGINEER SHALL NOT RELIEVE THE CONTRACTOR OF THE CONTRACTUAL RESPONSIBILITY FOR ANY ERRORS OR DEVIATION FROM THE CONTRACT REQUIREMENTS.

JOSH OLUND (REVIEWER) 07/03/2014 (DATE)

KENWAY CORP.

REV	DESCRIPTION	DATE
1	CHANGED NOTE ON REFERENCE LINES	6/25/14
1	ADDED 2" OVERLAP ON ALL 54 OZ PLIES	6/26/14

SEAL

DIMENSIONS ARE IN INCHES
TOLERANCES: +0, -1/16"
FRACTIONAL ± ANGULAR MACH ± BEND ±
TWO PLACE DECIMAL ± THREE PLACE DECIMAL ±

DRAWN BY	DATE
ML	6/4/14
CHKD BY	DATE
JM	6/4/14

PROJECT: BROOKFIELD FRP PONTOONS

CUSTOMER: MILLER CONST. / VTRANS

SHEET: HULLS 3-8 LAYUP SCHEDULE

WEIGHT: 4,205 lb

DESCRIPTION: FABRICATION

SCALE 1 : 72

WO NO. 8420

CONTRACT NO. 9185

DWG NO. 8420-6

SHEET 3 OF 16

PONTOON	PART NO.
3-8	1