STATE OF VERMONT
AGENCY OF TRANSPORTATION

TRAFFIC SIGN SUMMARY SHEET 2

MILEMARKER, STATION, OR SIGN NUMBER	SIGN LEGEND	SIGN DIMENSIONS EA	WIDTH (in)	HEIGHT (in)	NEW & SALVAGED SIGNS "A"	"B"	SALV SIGN	SALV TIS	EXIST POST RETAIN	SALVAGE	NEW SIGN POSTS NO. OF POSTS	FLANGED CHANNEL lb/ft 1.12	2.0	3.0	SQUARE STEEL (in) 1.75 lb/ft 1.88	2.0 2.42	2.5 3.35	ANCHOR	SLEEVE	TUBULAR ALUMINUM Ø (in) 3.0 lb/ft 1.3	4.0 1.7	4.0 MOD 1.7	FOUNDATION	TUBULAR STEEL Ø (in) 3.0 lb/ft 7.6	3.5 9.0	4.0 10.8	5.0 14.6	W-SHAPE STEEL FTG. SIZE 24"	30"	WEIGHT	POST SIZE	SIGN FRAME REQUIRED	REMARKS	SIGN DETAIL SHSM	DETAIL ON SHEET NUMBER	STD. SHEET NUMBER
												OPTION ITEMS																										
STA. 214+77.24, RT 4.24'		1	24	30	5.00						1	Signs and post installed 5/18/18. 12.5' post assembly (4' anchor).				X		X																BACK TO BACK MOUNT	R3-7L		
		1	18	18	2.25																													OM1-1		
		1	30	30	6.25																													R4-7		
		1	18	18	2.25																													OM1-1		
STA. 217+32.18, RT 46.45		1	24	12	2.00						1	Signs and post installed 5/18/18. 11' post assembly (2.25' anchor).				X		X																M3-1 GREEN ON WHITE Anchor was cut short due to great amounts of rock and sturdiness of anchor.			E-136B
		1	30	24	5.00																													M1-6B GREEN ON WHITE			E-136B
STA. 217+34.45, LT 38.74'		1	36	30	7.50						1	Sign and post installed 5/18/18. 12.5' post assembly (4' anchor).				X		X																VR-921			E-145A
STA. 219+06.57, RT 48.38'		1	72	12	6.00						2	Signs and posts installed 5/22/18. 12' post assembly (4' anchor), 11.75' post assembly (4' anchor).				X		X																VD2-1			T-93
		1	72	12	6.00																													VD2-1			T-93
STA. 219+14.21, LT 40.44'		1	24	12	2.00						2	Signs and posts installed 5/18/18. 2 slip bases installed, 10.5' post, 11.25' post.						X	X															M3-1 GREEN ON WHITE			E-136B
		1	30	24	5.00																													M1-5 GREEN ON WHITE			E-136B
		1	21	15	2.19																													M6-1L GREEN ON WHITE			E-136B
		1	24	12	2.00																												X T-92 3D	M3-3 GREEN ON WHITE			E-136B
		1	30	24	5.00																													M1-5 GREEN ON WHITE			E-136B
		1	21	15	2.19																													M6-3 GREEN ON WHITE			E-136B
		1	24	12	2.00																													M3-3 GREEN ON WHITE			E-136B
					SF 62.63							FT	FT	FT	FT	FT 75	FT 30		EA	LB	LB	LB		LB	LB	LB	LB									
					SF 209.78	SF	EA	SF				FT			FT 465					LB			EA	LB				EA	EA	LB						

SHSM = 2004 FHWA STANDARD HIGHWAY SIGNS & MARKINGS/2012 SUPP.
FYG = FLUORESCENT YELLOW GREEN

FINAL POST LENGTHS ARE TO BE DETERMINED IN THE FIELD. POST SIZES ARE COMPUTED BASED ON INFORMATION FURNISHED ON THE STANDARD SHEETS AND THE TRAFFIC & SAFETY DIVISION'S "SIGN POST DESIGN GUIDELINE."

SHEET TOTALS

PROJECT NAME: LUDLOW
PROJECT NUMBER: HES SGNL(44)

FILE NAME: t13b020_frm.dgn
PROJECT LEADER: P. COBURN
DESIGNED BY: M. BOGACZYK
TRAFFIC SIGN SUMMARY SHEET 2

PLOT DATE: 4/19/2017
DRAWN BY: M. BOGACZYK
CHECKED BY: P. COBURN
SHEET 32 OF 43