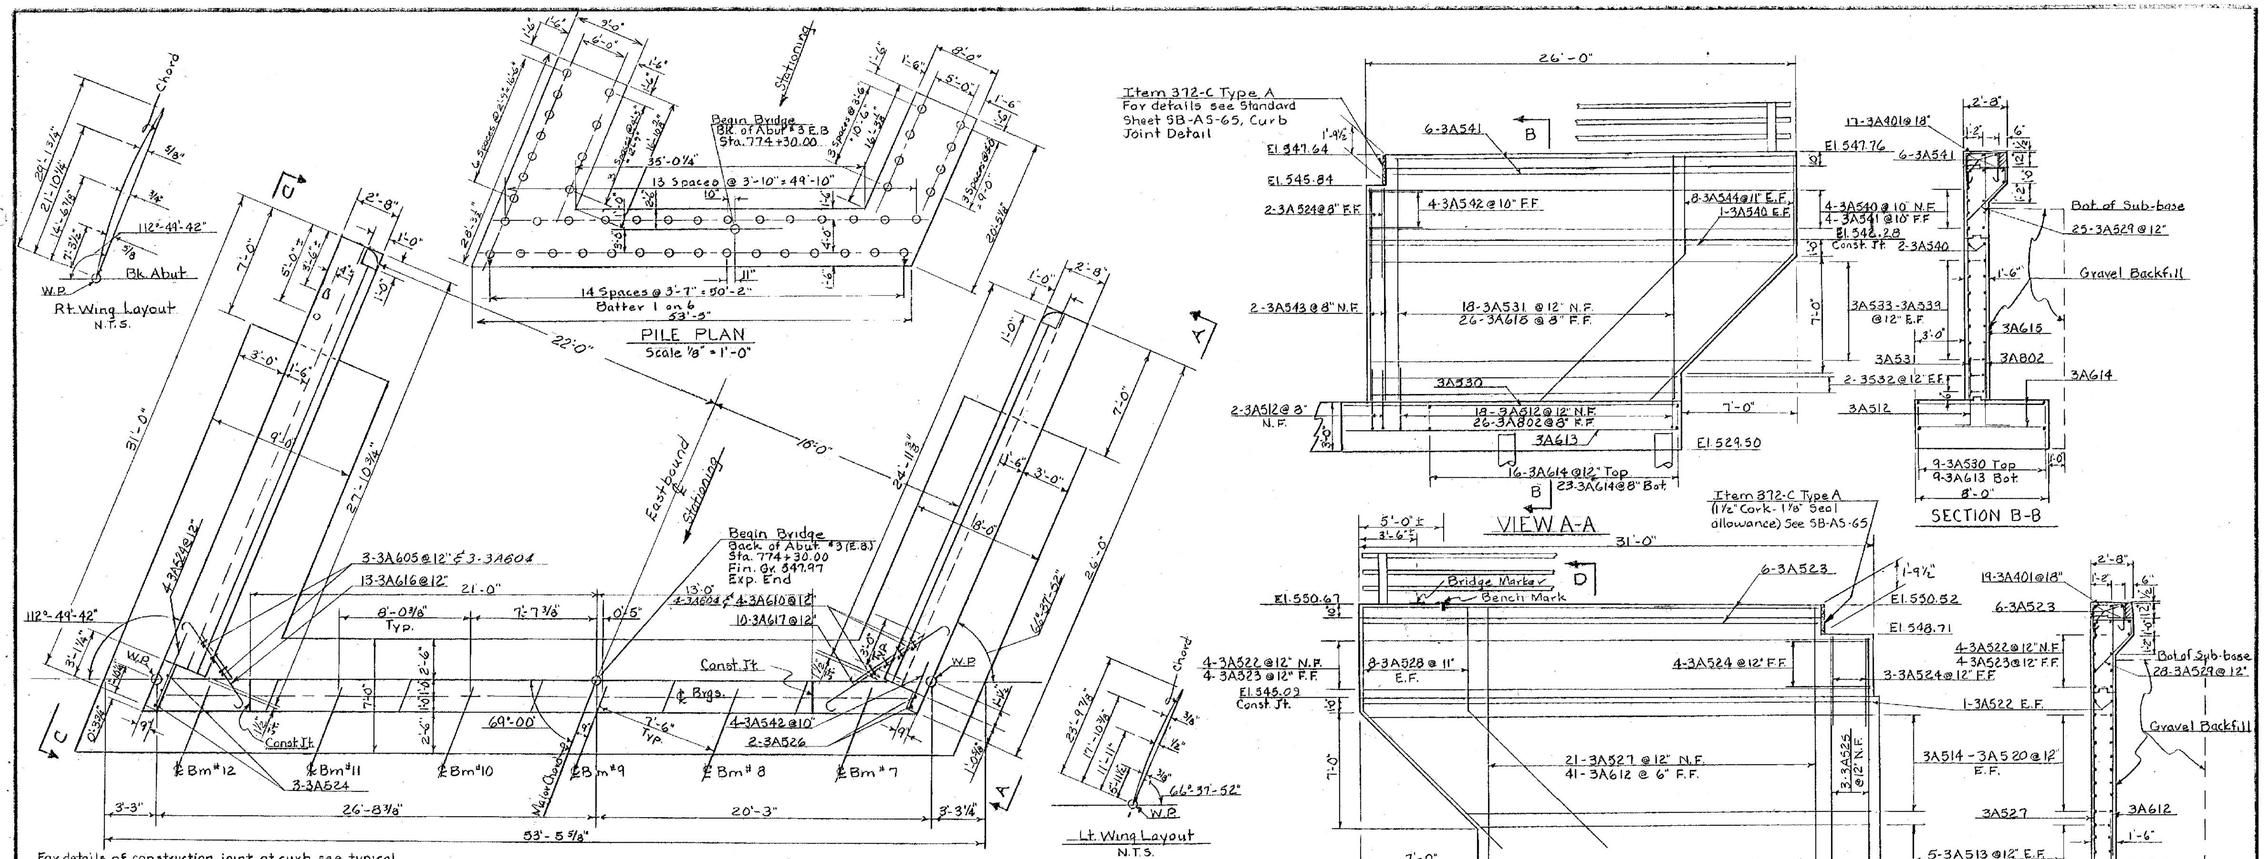

For details of construction joint at curb see typical section of superstructure. Standard Sheet SCB-38-65 and SCB-06-65

Do not construct above bridge seat elevations until structural steel is in place and final grade is determined. (Typ. both sides)

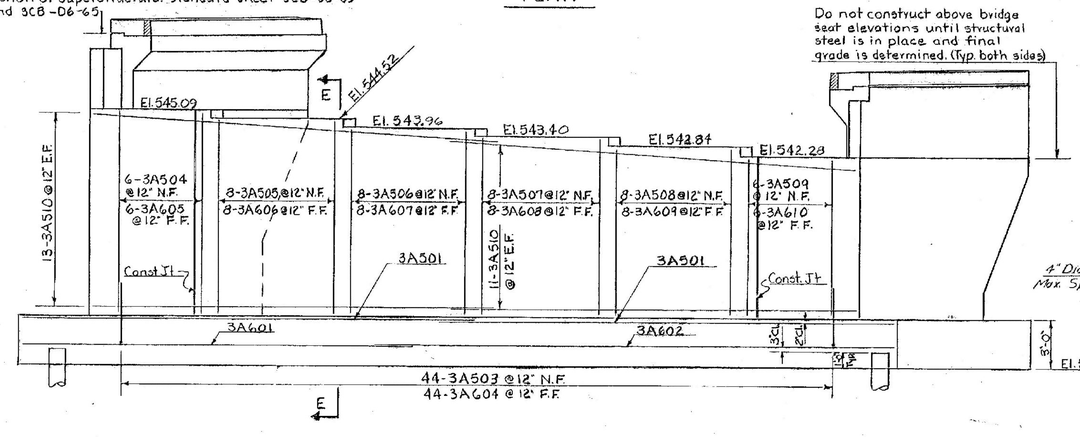

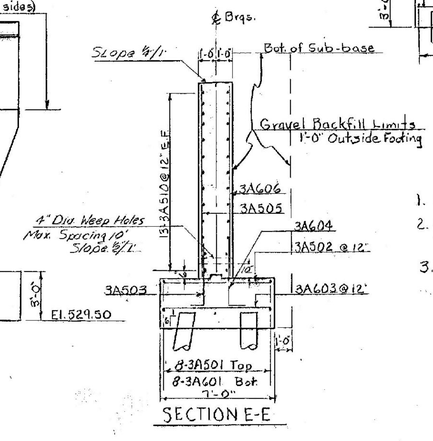

NOTES

1. For general notes see BR-300
2. All piles shall be driven to a minimum bearing capacity of 20 Tons.
3. 48 Treated Timber Piles. Estimated Length 25'

FAIR HAVEN - WEST RUTLAND
BF MEMB (35)
SHEET 41 OF 44
BRIDGE NO. 15E
FOR REFERENCE ONLY

STATE OF VERMONT
DEPARTMENT OF HIGHWAYS

PROJECT WEST RUTLAND
TOWN OF WEST RUTLAND
ROUTE NO US.4 STA. 774+50±
RELOC. U.S. 4 OVER VT 133
ABUTMENT #3 (E.B)
SCALE 1/4" = 1'-0" or as Noted
IN CHARGE W. SMITH
DRAWN BY Ouellette CHECKED BY D.W. Saal 12-65
PROJECT NO. A.P. 920-1(12)
SHEET 151 OF 359 BR-308

BR-7