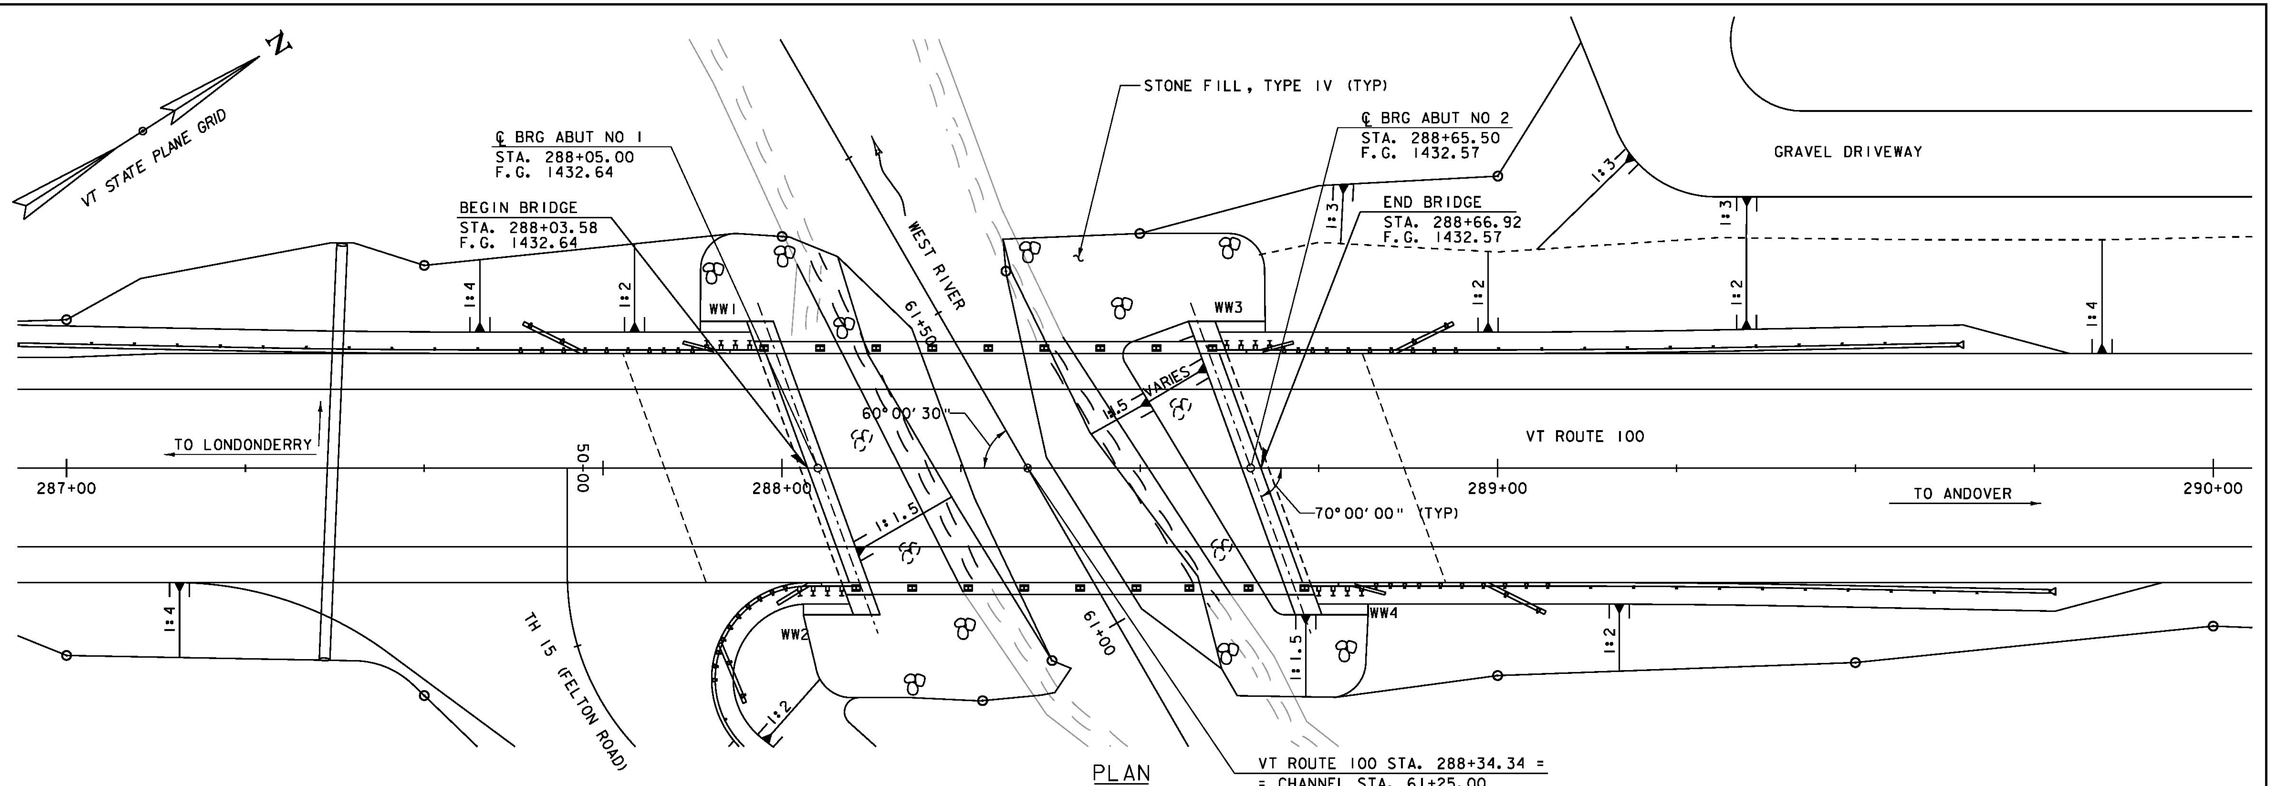

PLAN
SCALE 1" = 10'-0"

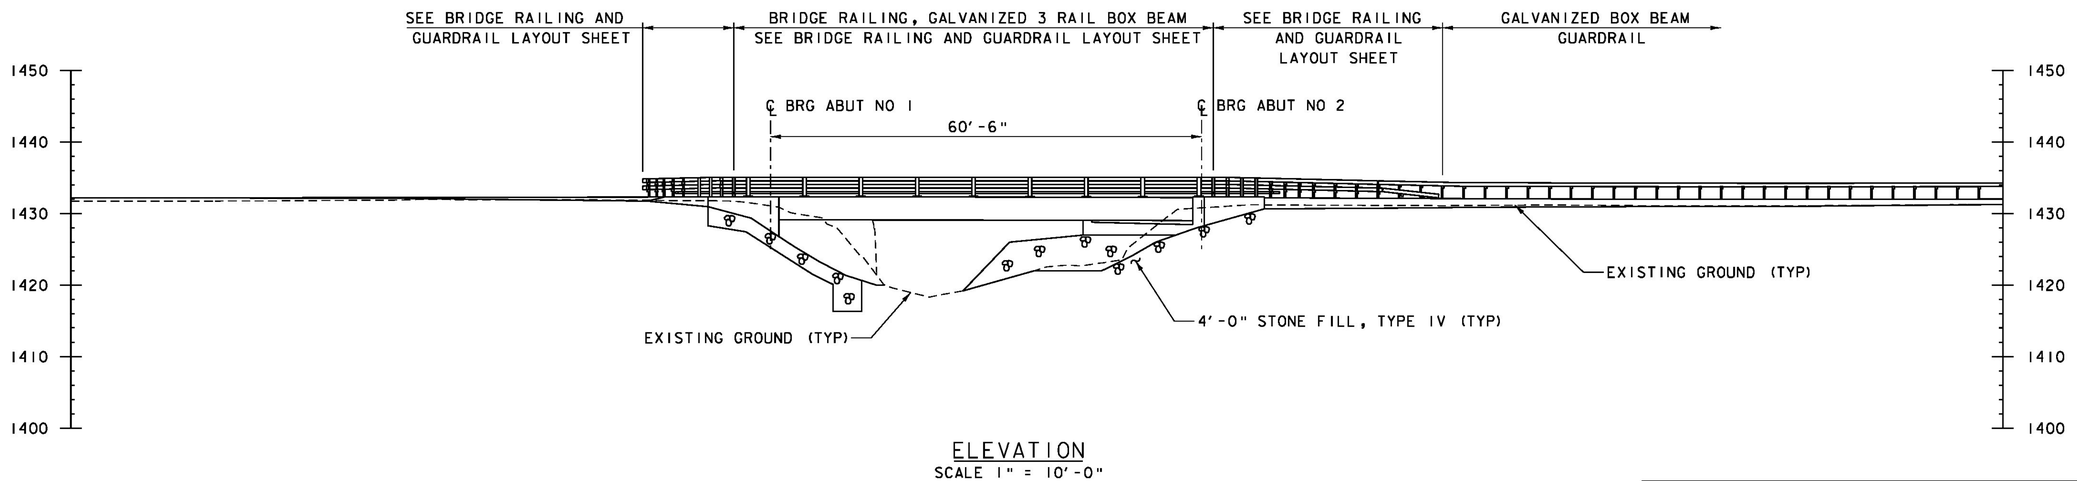

ELEVATION
SCALE 1" = 10'-0"

PROJECT NAME:	WESTON
PROJECT NUMBER:	BF 013-2(13)
FILE NAME: z13b076pe.dgn	PLOT DATE: 10/2/2015
PROJECT LEADER: S.E. BURBANK	DRAWN BY: J.J. WESTCOTT
DESIGNED BY: J.J. WESTCOTT	CHECKED BY: S.E. BURBANK
PLAN AND ELEVATION	SHEET 32 OF 68

VHB 57673