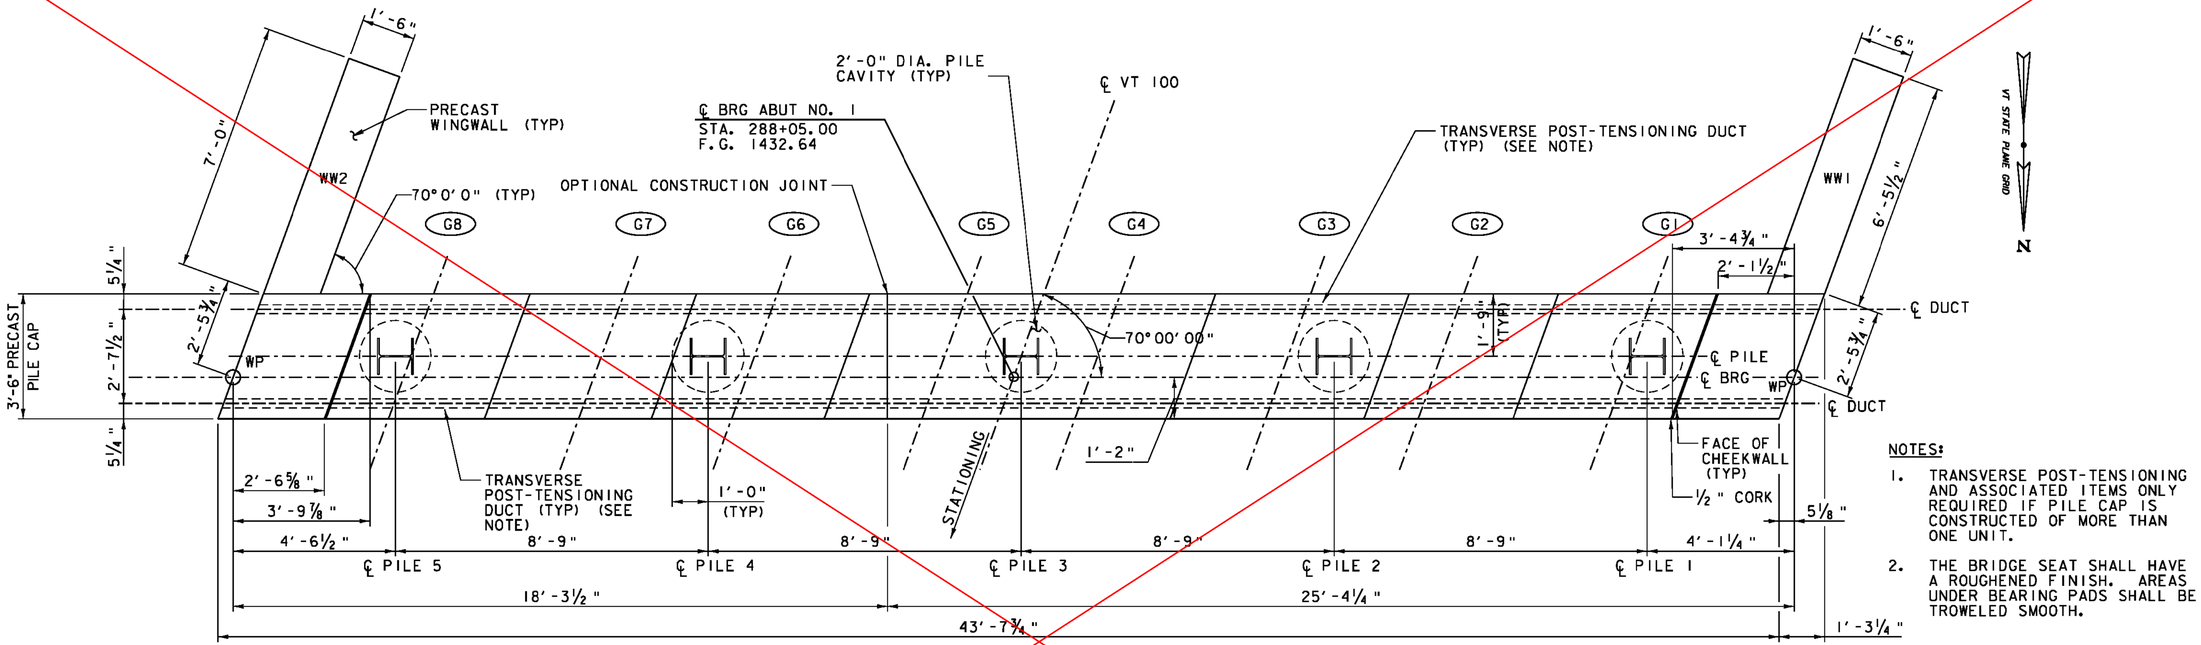

NOTES:

1. TRANSVERSE POST-TENSIONING AND ASSOCIATED ITEMS ONLY REQUIRED IF PILE CAP IS CONSTRUCTED OF MORE THAN ONE UNIT.
2. THE BRIDGE SEAT SHALL HAVE A ROUGHENED FINISH. AREAS UNDER BEARING PADS SHALL BE TROWELED SMOOTH.

ABUTMENT NO 1 PLAN

SCALE ½"=1'-0"

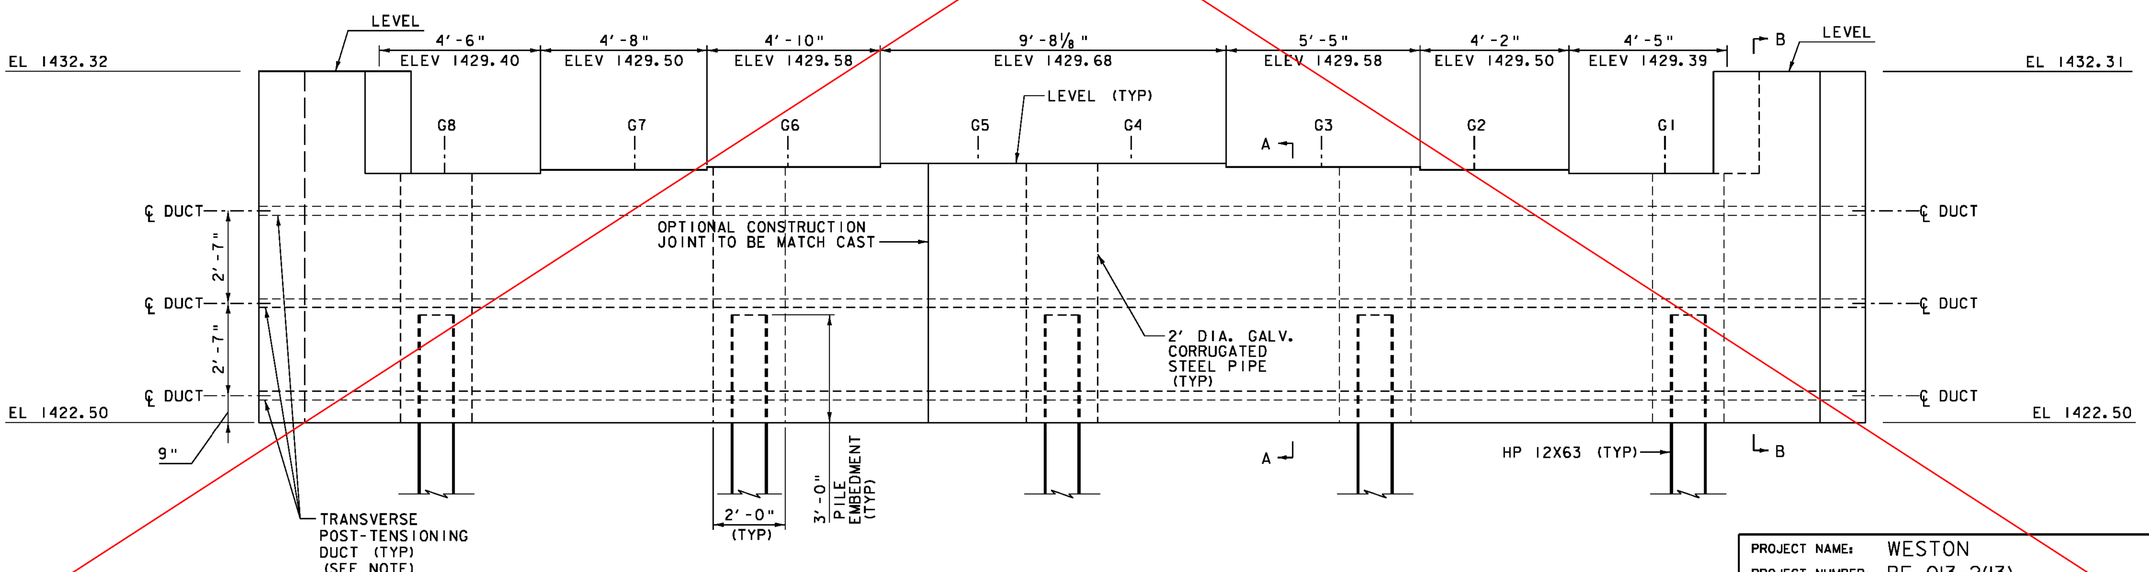

ABUTMENT NO 1 ELEVATION

SCALE ½"=1'-0"

SEE PBU ABUTMENT SECTIONS SHEET FOR SECTIONS A-A AND B-B.

PROJECT NAME:	WESTON
PROJECT NUMBER:	BF 013-2(13)
FILE NAME: z13b076sub2.dgn	PLOT DATE: 10/2/2015
PROJECT LEADER: S.E. BURBANK	DRAWN BY: J.J. WESTCOTT
DESIGNED BY: J.J. WESTCOTT	CHECKED BY: L.S. CHERVINCKY
PBU ABUT NO 1 PLAN & ELEVATION	SHEET 44 OF 68

VHB 57673