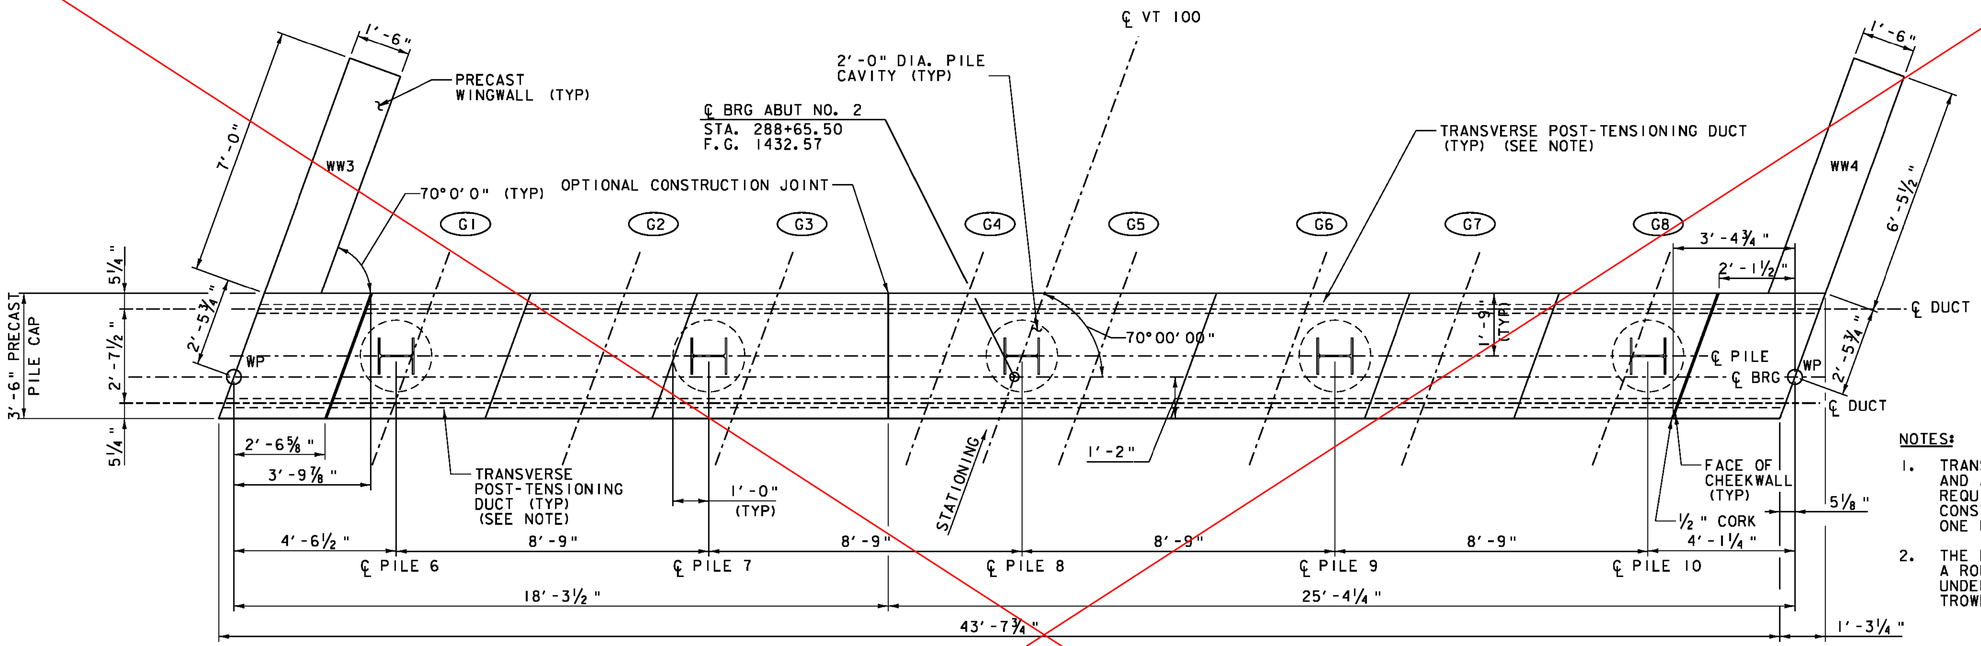

ABUTMENT NO 2 PLAN

SCALE ½"=1'-0"

NOTES:

1. TRANSVERSE POST-TENSIONING AND ASSOCIATED ITEMS ONLY REQUIRED IF PILE CAP IS CONSTRUCTED OF MORE THAN ONE UNIT.
2. THE BRIDGE SEAT SHALL HAVE A ROUGHENED FINISH. AREAS UNDER BEARING PADS SHALL BE TROWELED SMOOTH.

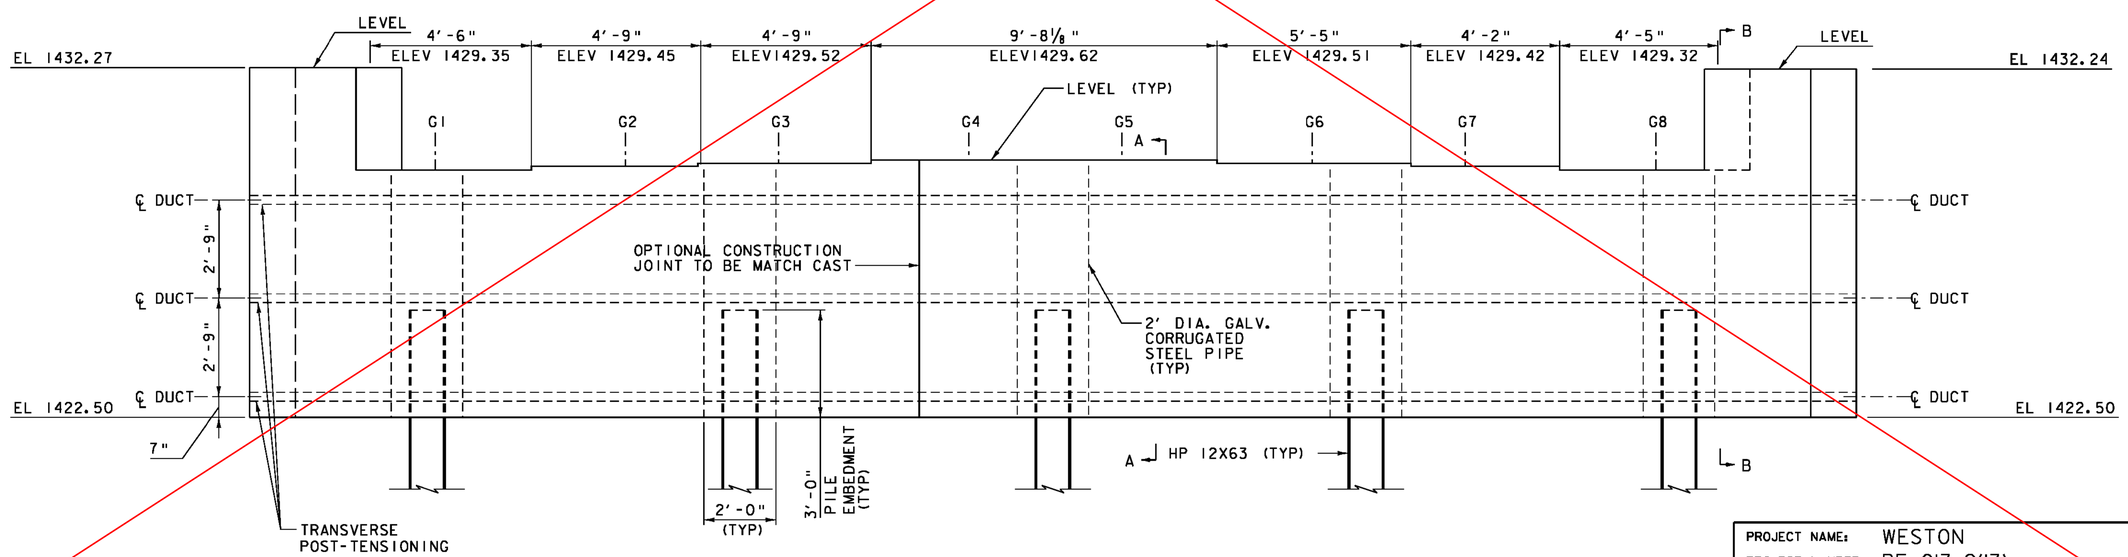

ABUTMENT NO 2 ELEVATION

SCALE ½"=1'-0"

SEE PBU ABUTMENT SECTIONS SHEET FOR SECTIONS A-A AND B-B.

PROJECT NAME: WESTON	
PROJECT NUMBER: BF 013-2(13)	
FILE NAME: zl3b076sub2.dgn	PLOT DATE: 10/2/2015
PROJECT LEADER: S.E. BURBANK	DRAWN BY: J.J. WESTCOTT
DESIGNED BY: J.J. WESTCOTT	CHECKED BY: L.S. CHERVINCKY
PBU ABUT NO 2 PLAN & ELEVATION	SHEET 45 OF 68

VHB 57673