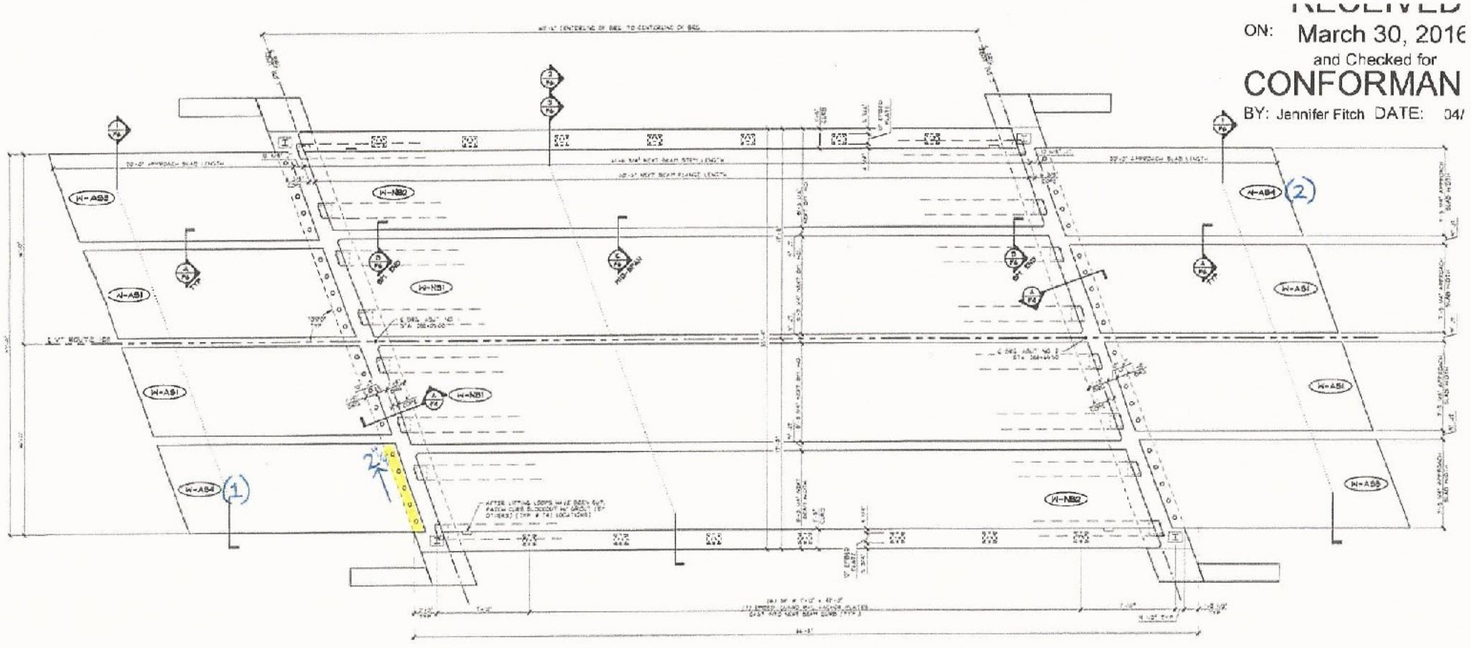

1 / F5 PRESTRESSED NEXT BEAM LAYOUT & PRECAST APPROACH SLAB LAYOUT

RECEIVED
ON: March 30, 2016
and Checked for
CONFORMAN
BY: Jennifer Fitch DATE: 04/