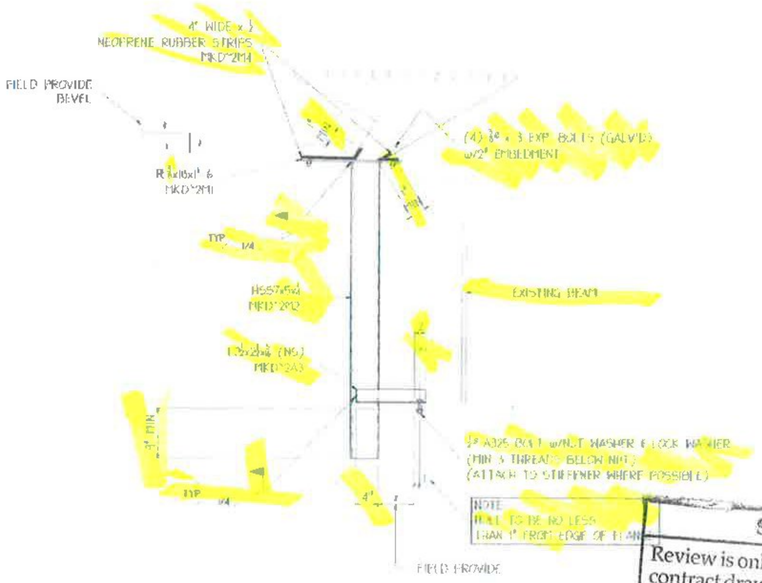

SCUPPER REPLACEMENT DETAIL

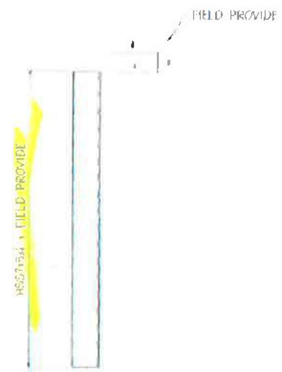

ONE - TUBE - 2M2

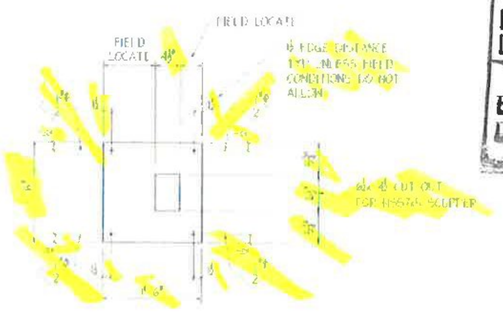

ONE - PLATE - 2M1

4 @ 3 ¾" EXP. BOLTS (GALV'D)

ONE - ANGLE - 2A3

1 @ 2½ ¾" A325

FIELD PROVIDE (ONE) ¾" x 2½ A325 BOLT w/NUT, WASHER & LOCK WASHER
(4) ¾" x 3 EXPANSION BOLT w/NUT, WASHER (GALV'D)

MATERIAL SCHEDULE

SHIPPING MARK	NO PCS	SIZE AGSDP	SHAPE	LENGTH FT	LENGTH IN	DIM	CUT PROV NO	CUT PROV FT	CUT PROV IN	REMARKS	WT
2M1	ONE		PL¾x10								
2M2	ONE		HSS7x5x¼							A500 GR-C	
2A3	ONE		L2½x2½x¼								
2M4			2 x 4" WIDE NEOPRENE RUBBER STRIPS								

TOTAL WEIGHT

PRINT DISTRIBUTION

MATERIAL ASTM A709, GR 50, UNO
BOLTS ¾" A325, UNO
SURFACE PREP SP3
PRIMER NONE
FINISH

HOLES ¾" HLS, UNO
ELECTRODE E70XX
REF DWG 4 OF 23

R.D. STEEL
WINTERPORT, MAINE 04496 • (207) 446-2302

DESCRIPTION SCUPPER REPLACEMENT DETAIL
PROJECT BENNINGTON - MT. FADOR (BF BPNI (16))
LOCATION BENNINGTON COUNTY, VT
DESIGNER PARSONS BRINCKERHOFF
CUSTOMER Manoko LLC, Tarpon Springs, FL

REV △
CHECK

SUBMITTAL REVIEW

Review is only for general conformity to the contract drawings and specifications and shall not relieve the contractor of his entire responsibility under the contract, including among other things, dimensions to be confirmed and correlated at the job site, and information that pertains to the fabrication processes or to techniques of construction.

☒ NO EXCEPTIONS TAKEN
☐ MAKE CORRECTIONS NOTED
RESUBMITTAL NOT REQUIRED
☐ AMEND AND RESUBMIT
☐ REJECTED - SEE REMARKS

PB AMERICAS, INC.
BY: Adam M. Steel
DATE: 4/20/16

Vermont Agency of Transportation

RECEIVED
ON: April 8, 2016
and Checked for
CONFORMANCE
BY: ABC DATE: