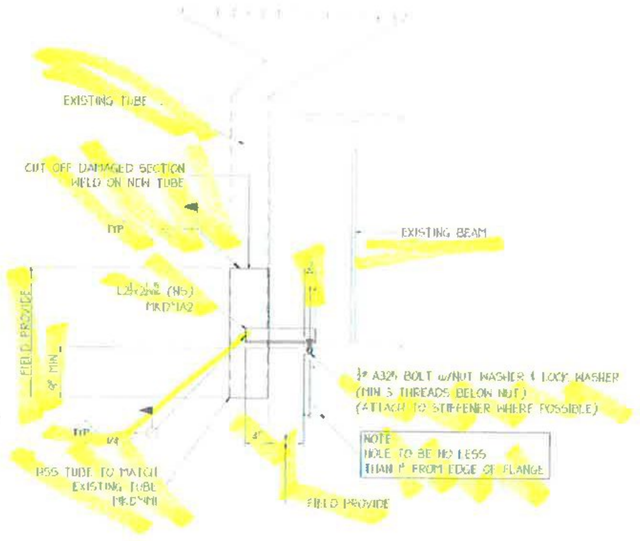


SCUPPER REPAIR DETAIL

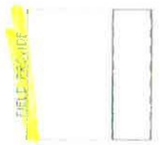


ONE - HSS TUBE - 1M1

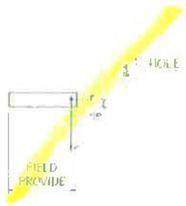


ONE - ANGLE - 1A2

C.B. THIS DWG
(ONE) 3/4" x 2 1/4 A325 BOLT w/NUT, WASHER & LOCK WASHER

**SUBMITTAL REVIEW**

Review is only for general conformity to the contract drawings and specifications and shall not relieve the contractor of his entire responsibility under the contract, including among other things, dimensions to be confirmed and correlated at the job site, and information that pertains to the fabrication processes or to techniques of construction.

- [x] NO EXCEPTIONS TAKEN
- [ ] MAKE CORRECTIONS NOTED
- [ ] RESUBMITTAL NOT REQUIRED
- [ ] AMEND AND RESUBMIT
- [ ] REJECTED - SEE REMARKS

PB AMERICAS, INC.
BY: Adam M. Abel
DATE: 4/20/16

Vermont Agency of Transportation
RECEIVED
ON: April 8, 2016
and Checked for
CONFORMANCE
BY: ABC DATE:

MATERIAL SCHEDULE

| SHIPPING MARK | NO PCS | SUB ASSEM | SHAPE | LENGTH FT | LENGTH IN | O OR S | CUT FROM NO | CUT FROM FT | CUT FROM IN | REMARKS | WT |
|---|---|---|---|---|---|---|---|---|---|---|---|
| 1M1 | ONE | | HSS TUBE | | | | | | | A500 GR-C | |
| 1A2 | ONE | | L 2 1/2 x 2 1/2 x 3/8 | | | | | | | A709 Gr50 | |

TOTAL WEIGHT

PRINT DISTRIBUTION

MATERIAL ASTM A709, GR 50, UNO
BOLTS 3/4" A325, UNO
SURFACE PREP SP3
PRIMER NONE
FINISH
HOLES 3/4" HLS, UNO
ELECTRODE E70XX
REF DWG. 4 OF 23

R.D. STEEL
WINTERPORT, MAINE 04496 • (207) 446-2402

DESCRIPTION SCUPPER REPAIR DETAIL
PROJECT BENNINGTON - MT TABOR (BF BPN1 (16))
LOCATION BENNINGTON COUNTY, VT
DESIGNER PARSONS BRINCKERHOFF
CUSTOMER Monoko LLC, Tarpon Springs, FL