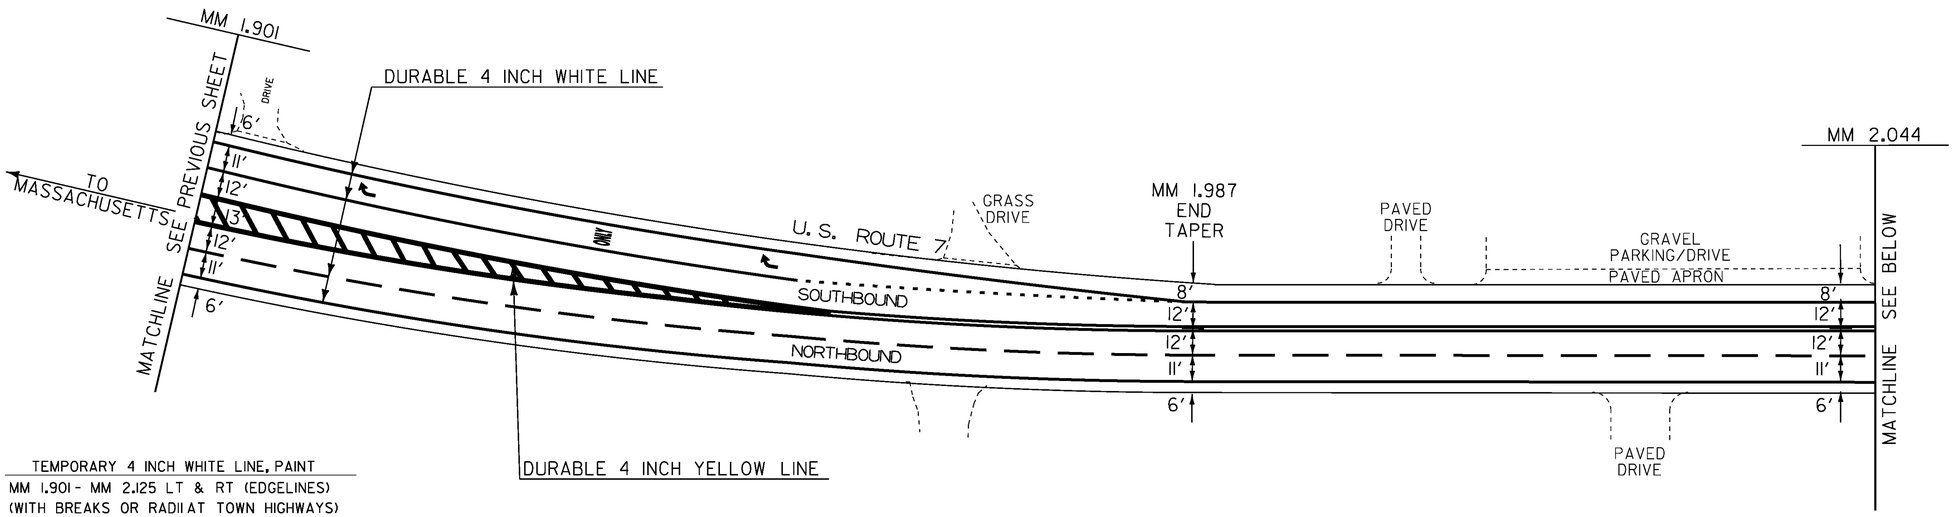

TEMPORARY 4 INCH WHITE LINE, PAINT

MM 1.901 - MM 2.125 LT & RT (EDGELINES)
(WITH BREAKS OR RADII AT TOWN HIGHWAYS)
MM 1.901 - MM 2.125 RT (LANE LINE - DASHED)
MM 1.901 - MM 1.934 LT (LANE LINE - SOLID)
MM 1.934 - MM 1.987 LT (LANE LINE - DOTTED)

DURABLE 4 INCH WHITE LINE, POLYUREA

MM 1.901 - MM 2.125 LT & RT (EDGELINES)
(WITH BREAKS OR RADII AT TOWN HIGHWAYS)
MM 1.901 - MM 2.125 RT (LANE LINE - DASHED)
MM 1.901 - MM 1.934 LT (LANE LINE - SOLID)
MM 1.934 - MM 1.987 LT (LANE LINE - DOTTED)

TEMPORARY LETTER OR SYMBOL, PAINT

MM 1.914 LT - ↱
MM 1.935 LT - "ONLY"
MM 1.949 LT - ↱

DURABLE LETTER OR SYMBOL (OPTION ITEM)

MM 1.914 LT - ↱
MM 1.935 LT - "ONLY"
MM 1.949 LT - ↱

TEMPORARY 4 INCH YELLOW LINE, PAINT

MM 1.901 - MM 1.934 SOLID LT & RT (CENTERLINE AT PAINTED ISLAND)
MM 1.934 - MM 2.125 SOLID LT & RT (CENTERLINE)
(WITH CENTERLINE BREAKS AT TOWN HIGHWAYS)

DURABLE 4 INCH YELLOW LINE, POLYUREA

MM 1.901 - MM 1.934 SOLID LT & RT (CENTERLINE AT PAINTED ISLAND)
MM 1.934 - MM 2.125 SOLID LT & RT (CENTERLINE)
(WITH CENTERLINE BREAKS AT TOWN HIGHWAYS)

TEMPORARY 8 INCH YELLOW LINE, PAINT

MM 1.901 - MM 1.934 SOLID LT & RT (DIAGONALS AT PAINTED ISLAND)

DURABLE 8 INCH YELLOW LINE, POLYUREA

MM 1.901 - MM 1.934 SOLID LT & RT (DIAGONALS AT PAINTED ISLAND)

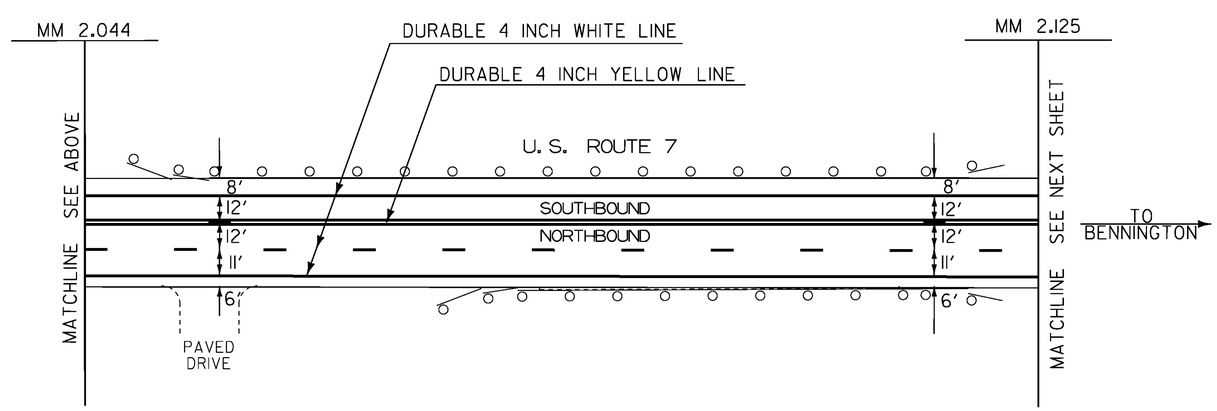

NOT TO SCALE

PROJECT SPECIAL MARKING LAYOUT SHEET #3	PROJECT NAME: POWNAL - BENNINGTON PROJECT NUMBER: NH SURF (42)	
	FILE NAME: 13b592\pl3b592.dgn PROJECT LEADER: FOWLER DESIGNED BY: LOCKE IPARM FILE NAME: pl3b592_12.1	PLOT DATE: 02-APR-2014 DRAWN BY: LOCKE CHECKED BY: PAVT MGMT SHEET 12 OF 23