TEMPORARY 4 INCH WHITE LINE, PAINT
(ALL LINES WILL INCLUDE EDGE LINE BREAKS AND RADIUS FOR TOWN HIGHWAYS)

MIDDLEBURY:
MM 1.131 - MM 1.454 LT & RT
MM 1.232 - MM 1.300 LANE LINE 12' LT
MM 1.237 - MM 1.274 12' RT
MM 1.237 (ALONG VT 125 EDGE OF ISLAND)
MM 1.274 - MM 1.300 DASHED LINE 12' RT
MM 1.300 - MM 1.305 DOTTED LINE 12' LT

DURABLE 4 INCH WHITE LINE, POLYUREA
(ALL LINES WILL INCLUDE EDGE LINE BREAKS AND RADIUS FOR TOWN HIGHWAYS)

MIDDLEBURY:
MM 1.131 - MM 1.454 LT & RT
MM 1.232 - MM 1.300 LANE LINE 12' LT
MM 1.237 - MM 1.274 12' RT
MM 1.237 (ALONG VT 125 EDGE OF ISLAND)
MM 1.274 - MM 1.300 DASHED LINE 12' RT
MM 1.300 - MM 1.305 DOTTED LINE 12' LT

TEMPORARY 4 INCH YELLOW LINE, PAINT
(ALL LINES WILL INCLUDE C/L BREAKS FOR TOWN HIGHWAYS) S=SOLID, D=DASHED

MIDDLEBURY:	LT	℄	RT
MM 1.131 - MM 1.136	S	-	S
MM 1.448 - MM 1.454	S	-	S

MM 1.136 - MM 1.176 DOUBLE SOLID LT & RT, (EDGE OF MEDIAN)
MM 1.176 - MM 1.220 LT & RT, (RAISED ISLAND)
MM 1.232 DOUBLE SOLID RT, VT-ROUTE 125
MM 1.237 - MM 1.305 SOLID LINE LT & RT
MM 1.239 - MM 1.249 (LT EDGE OF RAMP VT 125)
MM 1.305 - MM 1.341 SOLID LINE LT & RT (RAISED ISLAND)
MM 1.336 - MM 1.356 LT & RT (DASHED LINE BETWEEN ISLANDS)
MM 1.355 - MM 1.397 SOLID LINE LT & RT (RAISED ISLAND)
MM 1.397 - MM 1.448 DOUBLE SOLID LT & RT (EDGE OF MEDIAN)

DURABLE 4 INCH YELLOW LINE, POLYUREA
(ALL LINES WILL INCLUDE C/L BREAKS FOR TOWN HIGHWAYS) S=SOLID, D=DASHED

MIDDLEBURY:	LT	℄	RT
MM 1.131 - MM 1.136	S	-	S
MM 1.448 - MM 1.454	S	-	S

MM 1.136 - MM 1.176 DOUBLE SOLID LT & RT, (EDGE OF MEDIAN)
MM 1.176 - MM 1.220 LT & RT, (RAISED ISLAND)
MM 1.232 DOUBLE SOLID RT, VT-ROUTE 125
MM 1.237 - MM 1.305 SOLID LINE LT & RT
MM 1.239 - MM 1.249 (LT EDGE OF RAMP VT 125)
MM 1.305 - MM 1.341 SOLID LINE LT & RT (RAISED ISLAND)
MM 1.336 - MM 1.356 LT & RT (DASHED LINE BETWEEN ISLANDS)
MM 1.355 - MM 1.397 SOLID LINE LT & RT (RAISED ISLAND)
MM 1.397 - MM 1.448 DOUBLE SOLID LT & RT (EDGE OF MEDIAN)

TEMPORARY 24 INCH STOP BAR, PAINT
MIDDLEBURY:
MM 1.235 RT, VT. ROUTE 125

DURABLE 24 INCH STOP BAR (OPTION BID ITEM)
MIDDLEBURY:
MM 1.235 RT, VT. ROUTE 125

TEMPORARY LETTER OR SYMBOL, PAINT
MIDDLEBURY:
MM 1.235 RT, VT. ROUTE 125, "S,T,O,P" (4 EA)
MM 1.237 - MM 1.239 LT, ARROW (1 EA)
MM 1.252 - MM 1.254 LT, "O,N,L,Y" (4 EA)
MM 1.267 - MM 1.269 LT, ARROW (1 EA)
MM 1.282 - MM 1.284 LT, "O,N,L,Y" (4 EA)
MM 1.297 - MM 1.299 LT, ARROW (1 EA)

DURABLE LETTER OR SYMBOL (OPTION BID ITEM)
MIDDLEBURY:
MM 1.235 RT, VT. ROUTE 125, "S,T,O,P" (4 EA)
MM 1.237 - MM 1.239 LT, ARROW (1 EA)
MM 1.252 - MM 1.254 LT, "O,N,L,Y" (4 EA)
MM 1.267 - MM 1.269 LT, ARROW (1 EA)
MM 1.282 - MM 1.284 LT, "O,N,L,Y" (4 EA)
MM 1.297 - MM 1.299 LT, ARROW (1 EA)

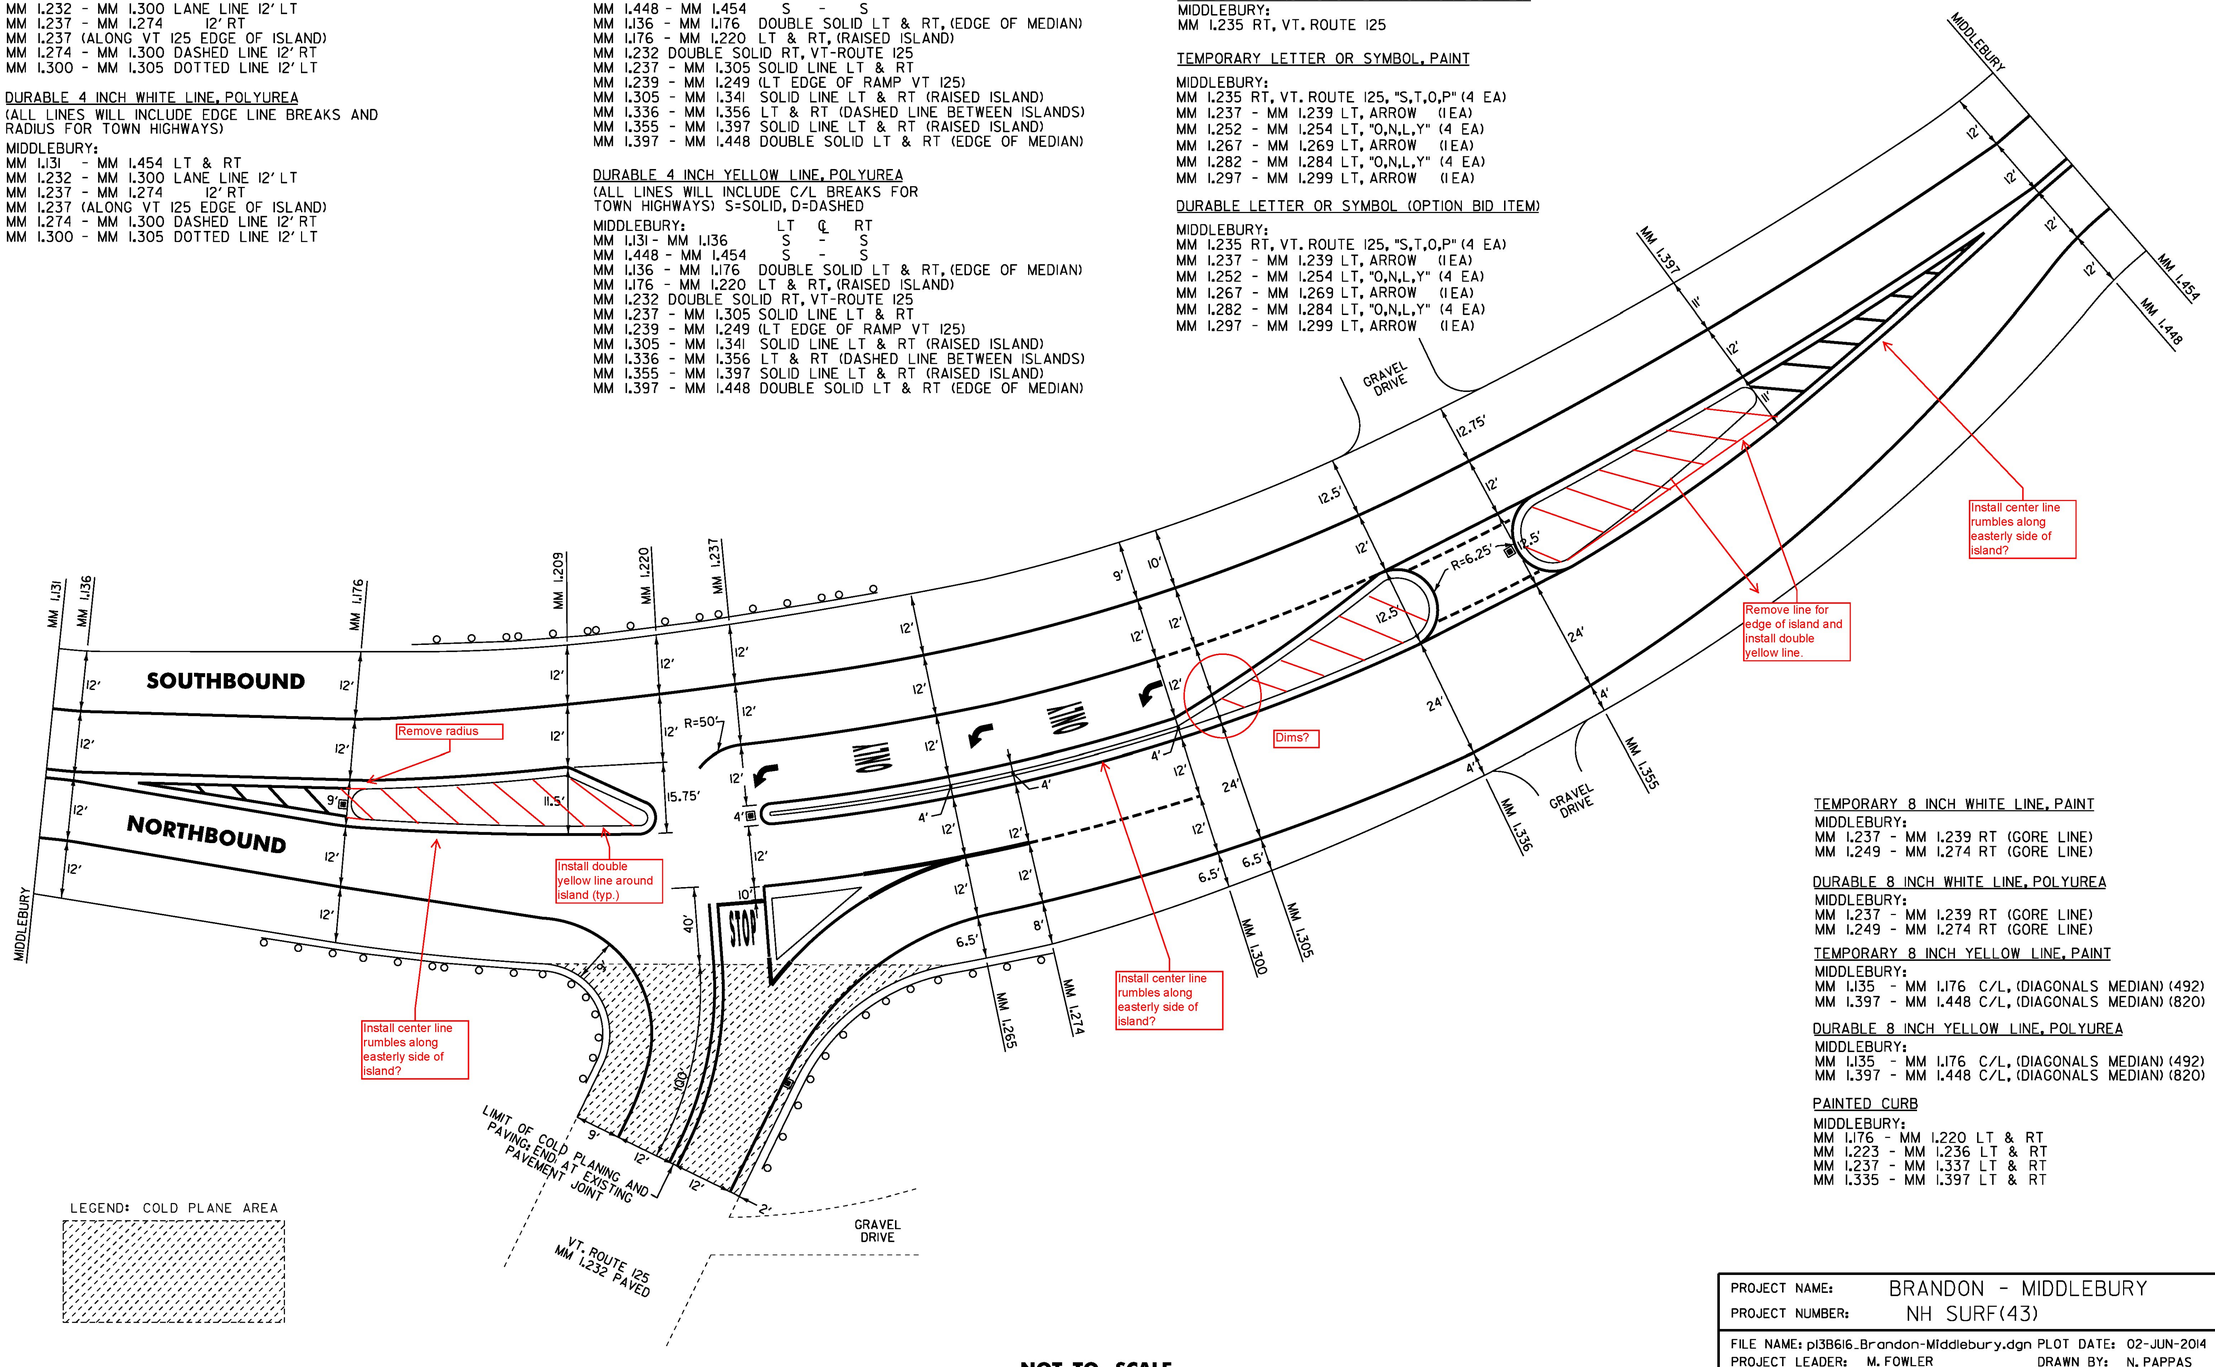

TEMPORARY 8 INCH WHITE LINE, PAINT
MIDDLEBURY:
MM 1.237 - MM 1.239 RT (GORE LINE)
MM 1.249 - MM 1.274 RT (GORE LINE)

DURABLE 8 INCH WHITE LINE, POLYUREA
MIDDLEBURY:
MM 1.237 - MM 1.239 RT (GORE LINE)
MM 1.249 - MM 1.274 RT (GORE LINE)

TEMPORARY 8 INCH YELLOW LINE, PAINT
MIDDLEBURY:
MM 1.135 - MM 1.176 C/L, (DIAGONALS MEDIAN) (492)
MM 1.397 - MM 1.448 C/L, (DIAGONALS MEDIAN) (820)

DURABLE 8 INCH YELLOW LINE, POLYUREA
MIDDLEBURY:
MM 1.135 - MM 1.176 C/L, (DIAGONALS MEDIAN) (492)
MM 1.397 - MM 1.448 C/L, (DIAGONALS MEDIAN) (820)

PAINTED CURB
MIDDLEBURY:
MM 1.176 - MM 1.220 LT & RT
MM 1.223 - MM 1.236 LT & RT
MM 1.237 - MM 1.337 LT & RT
MM 1.335 - MM 1.397 LT & RT

NOT TO SCALE
NOTE: SEE TYPICAL MARKINGS FOR TURN LANES ON LAYOUT SHEET 13.

PROJECT NAME:	BRANDON - MIDDLEBURY
PROJECT NUMBER:	NH SURF(43)
FILE NAME: p13B616_Brandon-Middlebury.dgn	PLOT DATE: 02-JUN-2014
PROJECT LEADER: M. FOWLER	DRAWN BY: N. PAPPAS
DESIGNED BY: N. PAPPAS	CHECKED BY: M. FOWLER
LAYOUT SHEET 9	SHEET 16 OF 28