DIRECTION	MILEPOINT	LOCATION CODE (SHEET 2)	SIGN CODE	WIDTH (IN)	HEIGHT (IN)	SHEETING REMARKS	SIGN LEGEND	NEW SIGNS "A"	NEW SIGNS "B"	EXISTING SIGNS RETAIN	EXISTING SIGNS SALVAGE FROM	EXISTING SIGNS SALVAGE TO	EXISTING SIGNS REMOVE	EXIST POST RETAIN	EXIST POST REMOVE	NUMBER OF NEW POSTS	SQUARE STEEL (IN) 1.75 (LB/FT) 1.88	SQUARE STEEL (IN) 2.00 (LB/FT) 2.42	SQUARE STEEL (IN) 2.50 (LB/FT) 3.35	TUBULAR STEEL Ø (IN) FOUNDATION	TUBULAR STEEL Ø (IN) 3.00 (LB/FT) 7.60	TUBULAR STEEL Ø (IN) 3.50 (LB/FT) 9.00	TUBULAR STEEL Ø (IN) 4.00 (LB/FT) 10.80	TUBULAR STEEL Ø (IN) 5.00 (LB/FT) 14.60	SIGN FRAME REQUIRED	REMARKS	SIGN DETAIL LOCATION SHSM	SIGN DETAIL LOCATION PROJECT SHEET #	SIGN DETAIL LOCATION STANDARD SHEET #
BAKERSFIELD VT-108 NB							FY-FLUORESCENT YELLOW FYG-FLUORESCENT YELLOW GREEN																			"SHSM"-STANDARD HIGHWAY SIGNS AND MARKINGS			
NB	3.487	A	R2-1	24	30		SPEED LIMIT 35			1				X															
NB	3.584	A	M1-5	24	24		JCT STATE 5/4						1		X														
		A	M2-1	21	15		VERMONT 36 5/4						1																
		A	M2-1	21	15	GRN/WHT	TRIM 5/4	2.19								1		14.25 X								X		
		A	M1-5	24	24	GRN/WHT	5/4	4.00																				E-136B
NB	3.625	A	D1-1a	72	10		^UP ENOSBURG FALLS 9 5/4						1		X														
		A	D1-1a	72	10		<--- FAIRFIELD 8 5/4						1																
		A	D1-1a	72	10		<--- ST ALBANS 15 5/4						1																
		A	VD1-1a	72	12		TRIM 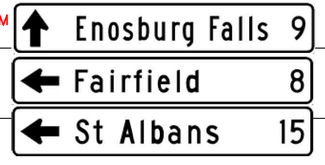 5/4	6.00								2		28.00 X										7	
		A	VD1-1a	72	12		5/4	6.00																				7	
		A	VD1-1a	72	12		5/4	6.00																				7	
NB	3.658	A	M3-4	24	12		WEST STATE 6/30						1		X														
		A	M1-5	24	24		VERMONT 36 6/30						1																
		A	M6-1L	21	115		<-- LEFT ARROW STATE 6/30						1																
		A	M3-1	24	12		NORTH STATE 6/30						1																
SIGN SUMMARY SHEET							SHEET TOTALS	24.19	0.00	1	0	0	9	0	0	3		42.25 ~~45.0~~		0	0.0	0.0	0.0	0.0				
								SF	SF	EA	EA	EA	EA	EA	EA	EA		FT		EA	LB	LB	LB	LB				
VERMONT AGENCY OF TRANSPORTATION							TOWN DIRECTIONAL TOTALS	191.4	0.0	6	4	4	48	0	0	30		450.0		0	0.0							

PROJECT NAME: **STOWE - BERKSHIRE**
PROJECT NUMBER: **STPG SIGN (49)**
FILE NAME: **05 BAKERSFIELD VT-108 NB T** PLOT DATE: **4/15/2015**
PROJECT MANAGER: **D. BRYANT** DRAWN BY: **J. BLANCHARD**
DESIGNED BY: **J. BLANCHARD** CHECKED **K. KERN**
BAKERSFIELD NB SHEET 1 SHEET **85** OF **131**