DIRECTION	MILEPOINT	LOCATION CODE (SHEET 2)	SIGN CODE	WIDTH (IN)	HEIGHT (IN)	SHEETING REMARKS	SIGN LEGEND	NEW SIGNS "A"	NEW SIGNS "B"	EXISTING SIGNS RETAIN	EXISTING SIGNS SALVAGE FROM	EXISTING SIGNS SALVAGE TO	EXISTING SIGNS REMOVE	EXIST POST RETAIN	EXIST POST REMOVE	NUMBER OF NEW POSTS	SQUARE STEEL (IN) 1.75 (LB/FT) 1.88	SQUARE STEEL (IN) 2.00 (LB/FT) 2.42	SQUARE STEEL (IN) 2.50 (LB/FT) 3.35	TUBULAR STEEL Ø (IN) FOUNDATION	TUBULAR STEEL Ø (IN) 3.00 (LB/FT) 7.60	TUBULAR STEEL Ø (IN) 3.50 (LB/FT) 9.00	TUBULAR STEEL Ø (IN) 4.00 (LB/FT) 10.80	TUBULAR STEEL Ø (IN) 5.00 (LB/FT) 14.60	SIGN FRAME REQUIRED	REMARKS	SIGN DETAIL LOCATION SHSM	SIGN DETAIL LOCATION PROJECT SHEET #	SIGN DETAIL LOCATION STANDARD SHEET #
CALAIS VT-14 NB							FY-FLUORESCENT YELLOW FYG-FLUORESCENT YELLOW GREEN																				"SHSM"-STANDARD HIGHWAY SIGNS AND MARKINGS			
NB	1.963	A	S3-1	30	30		SCHOOL BUS STOP AHEAD						1		X														
NB	2.029	A	S3-1	36	36	FYG		9.00								2		15'-3" X 13'-6"									INSTALL 350 FT NORTH OF EXISTING	X		
NB	2.306	A/B	D3-1	52	12			~~4.33~~ ~~4.67~~								2		12'-3" X 11'-6"									STILL BROOK RD (TH-52); INSTALL 10 FT FROM EDGE OF PAVEMENT, IN LINE WITH LLL		8	
NB	2.306	C	VR-017	24	30		LLL 16,000 LBS						1		X														
		C	UNK.	UNK.	UNK.		NEIGHBORHOOD WATCH				1		1														SALVAGE AND RETURN TO TOWN			
		C	VR-017	24	30			5.00								1		14'-0" X									STILL BROOK RD (TH-52)		6	
NB	2.311	D	R1-1	30	30		STOP						1		X														
		C	VD-700	6	10		MILE MARKER				1	1	1														STILL BROOK RD (TH-52); SALVAGE AND MOUNT ON NEW POST BELOW STOP SIGN			
		D	R1-1	30	30			6.25								1		13'-3" X									STILL BROOK RD (TH-52)	X		
NB	2.312	A/B	D3-1	UNK.	UNK.		STILL BROOK RD						1		X														
		D	D3-1	UNK.	UNK.		RTE 14						1																
NB	4.230	A	W3-5	36	36		SPEED REDUCTION SPEED LIMIT 35						1		X														
		A	W3-5	36	36			9.00								2		13'-6" X 13'-9"										X		
NB	4.308	A	VD-018	30	18		EAST CALAIS SOUTH WOODBURY 4						~~1~~		X														
		A	VD-018	30	18		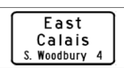 INSTALLED BY DISTRICT PRIOR TO PROJECT START	~~3.75~~								~~1~~		~~X~~								REQUIRES VEGETATION CLEARING		5	
							SHEET TOTALS	37.67	0.00	0	2	1	9	0	0	9		135.0		0	0.0	0.0	0.0	0.0				
								SF	SF	EA	EA	EA	EA	EA	EA	EA		FT		EA	LB	LB	LB	LB				
							TOWN DIRECTIONAL TOTALS	210.8	0.0	8	13	9	52	0	0	42		630.0		0	0.0							

7/15/16

7/18/16

SIGN SUMMARY SHEET

VERMONT AGENCY OF TRANSPORTATION

PROJECT NAME: CALAIS - GREENSBORO
PROJECT NUMBER: STPG SIGN (50)

FILE NAME: 01 CALAIS VT-14 NB.xls
PROJECT MANAGER: D. BRYANT
DESIGNED BY: J. BLANCHARD
CALAIS NB SHEET 3

PLOT DATE: 5/19/2015
DRAWN BY: J. BLANCHARD
CHECKED K. KERN
SHEET 12 OF 66