| DIRECTION | MILEPOINT | LOCATION CODE (SHEET 2) | SIGN CODE | WIDTH (IN) | HEIGHT (IN) | SHEETING REMARKS | SIGN LEGEND | NEW SIGNS "A" | NEW SIGNS "B" | EXISTING SIGNS RETAIN | EXISTING SIGNS SALVAGE FROM | EXISTING SIGNS SALVAGE TO | EXISTING SIGNS REMOVE | EXIST POST RETAIN | EXIST POST REMOVE | NUMBER OF NEW POSTS | SQUARE STEEL (IN) 1.75 (LB / FT) 1.88 | SQUARE STEEL (IN) 2.00 (LB / FT) 2.42 | SQUARE STEEL (IN) 2.50 (LB / FT) 3.35 | TUBULAR STEEL Ø (IN) FOUNDATION | TUBULAR STEEL Ø (IN) 3.00 (LB / FT) 7.60 | TUBULAR STEEL Ø (IN) 3.50 (LB / FT) 9.00 | TUBULAR STEEL Ø (IN) 4.00 (LB / FT) 10.80 | TUBULAR STEEL Ø (IN) 5.00 (LB / FT) 14.60 | SIGN FRAME REQUIRED | REMARKS | SIGN DETAIL LOCATION SHSM | SIGN DETAIL LOCATION PROJECT SHEET # | SIGN DETAIL LOCATION STANDARD SHEET # |
|---|---|---|---|---|---|---|---|---|---|---|---|---|---|---|---|---|---|---|---|---|---|---|---|---|---|---|---|---|---|
| **HARDWICK VT-14 SB** | | | | | | | FY-FLUORESCENT YELLOW<br>FYG-FLUORESCENT YELLOW GREEN | | | | | | | | | | | | | | | | | | | "SHSM"-STANDARD HIGHWAY SIGNS AND MARKINGS | | | |
| | | F | M1-5 | 24 | 24 | GRN/ WHT | | 4.00 | | | | | | | | | | | | | | | | | | | | E-136B |
| | | F | M6-3 | 21 | 15 | GRN/ WHT | | 2.19 | | | | | | | | | | | | | | | | | | | X | | |
| | | F | M3-4 | 24 | 12 | GRN/ WHT | 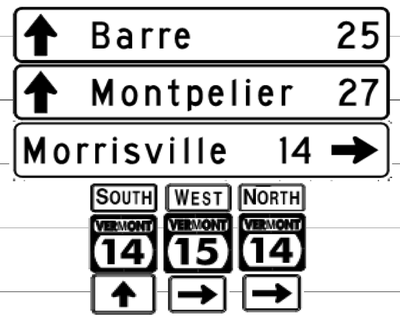 | 2.00 | | | | | | | | | | | | | | | | | | X | | |
| | | F | M1-5 | 24 | 24 | GRN/ WHT | | 4.00 | | | | | | | | | | | | | | | | | | | | E-136B |
| | | F | M6-1 | 21 | 15 | GRN/ WHT | | 2.19 | | | | | | | | | | | | | | | | | | | X | | |
| | | F | M3-1 | 24 | 12 | GRN/ WHT | | 2.00 | | | | | | | | | | | | | | | | | | | X | | |
| | | F | M1-5 | 24 | 24 | GRN/ WHT | | 4.00 | | | | | | | | | | | | | | | | | | | | E-136B |
| | | F | M6-1 | 21 | 15 | GRN/ WHT | | 2.19 | | | | | | | | | | | | | | | | | | | X | | |
| | | G | VD1-1a | 72 | 12 | | | 6.00 | | | | | | | | | | | | | | | | | | | | 6 | |
| | | G | VD1-1a | 72 | 12 | | | 6.00 | | | | | | | | | | | | | | | | | | | | 6 | |
| | | G | VD1-1a | 72 | 12 | | | 6.00 | | | | | | | | | | | | | | | | | | | | 6 | |
| | | G | VD1-1a | 72 | 12 | | | 6.00 | | | | | | | | | | | | | | | | | | | | 6 | |
| | | G | M3-4 | 24 | 12 | GRN/ WHT | | 2.00 | | | | | | | | | | | | | | | | | | | X | | |
| | | G | M1-5 | 24 | 24 | GRN/ WHT | | 4.00 | | | | | | | | | | | | | | | | | | | | E-136B |
| | | G | M6-1 | 21 | 15 | GRN/ WHT | | 2.19 | | | | | | | | | | | | | | | | | | | X | | |
| **SIGN SUMMARY SHEET** | | | | | | | SHEET TOTALS | 54.75 | 0.00 | 0 | 0 | 0 | 0 | 0 | 0 | 0 | | 0.0 | | 0 | 0.0 | 0.0 | 0.0 | 0.0 | | | | | |
| | | | | | | | | SF | SF | EA | EA | EA | EA | EA | EA | EA | | FT | | EA | LB | LB | LB | LB | | | | | |
| VERMONT AGENCY OF TRANSPORTATION | | | | | | | TOWN DIRECTIONAL TOTALS | 301.8 | 0.0 | 8 | 11 | 11 | 75 | 0 | 0 | 52 | | 780.0 | | 2 | | 270.0 | | | | | | | |

8/23/16

PROJECT NAME: CALAIS - GREENSBORO
PROJECT NUMBER: STPG SIGN (50)
FILE NAME: 06 HARDWICK VT-14 SB TSS.) PLOT DATE: 5/19/2015
PROJECT MANAGER: D. BRYANT DRAWN BY: J. BLANCHARD
DESIGNED BY: J. BLANCHARD CHECKED K. KERN
HARDWICK SB SHEET 6 SHEET 56 OF 66