DIRECTION	MILEPOINT	LOCATION CODE (SHEET 2)	SIGN CODE	WIDTH (IN)	HEIGHT (IN)	SHEETING REMARKS	SIGN LEGEND	NEW SIGNS "A"	NEW SIGNS "B"	EXISTING SIGNS RETAIN	EXISTING SIGNS SALVAGE FROM	EXISTING SIGNS SALVAGE TO	EXISTING SIGNS REMOVE	EXIST POST RETAIN	EXIST POST REMOVE	NUMBER OF NEW POSTS	SQUARE STEEL (IN) 1.75 (LB / FT) 1.88	SQUARE STEEL (IN) 2.00 (LB / FT) 2.42	SQUARE STEEL (IN) 2.50 (LB / FT) 3.35	TUBULAR STEEL Ø (IN) FOUNDATION	TUBULAR STEEL Ø (IN) 3.00 (LB / FT) 7.60	TUBULAR STEEL Ø (IN) 3.50 (LB / FT) 9.00	TUBULAR STEEL Ø (IN) 4.00 (LB / FT) 10.80	TUBULAR STEEL Ø (IN) 5.00 (LB / FT) 14.60	SIGN FRAME REQUIRED	REMARKS	SIGN DETAIL LOCATION SHSM	SIGN DETAIL LOCATION PROJECT SHEET #	SIGN DETAIL LOCATION STANDARD SHEET #
HARDWICK VT-14 SB							FY-FLUORESCENT YELLOW FYG-FLUORESCENT YELLOW GREEN																			"SHSM"-STANDARD HIGHWAY SIGNS AND MARKINGS			
SB	1.439	H	R1-1	30	30		STOP						1		X													
		H	R1-1	30	30			6.25								1		13'-0" X								TERRACE HILL RD (SOUTH) (TH-372); INSTALL 10 FT BACK FROM STREET NAME SIGN	X		
SB	1.379	E/F	D3-1	UNK.	UNK.		LOWER CHERRY ST				I	I	1		X													
		H	R1-2	36	36		YIELD						1															
		H	D3-1	38	12		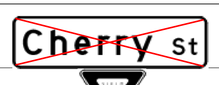	~~3.33~~								1		12'-6" X								CHERRY ST (TH-380); MOUNT TO YIELD SIGN POST WITH BRACKET		9	
		H	R1-2	36	36			~~9.00~~ 3.90																		CHERRY ST (TH-380); REQUIRES VEGETATION CLEARING	X		
SB	1.357	G	UNK.	UNK.	UNK.		NO PARKING ON SIDEWALK						1		X													
		G	R8-3a	24	24 ~~30~~			~~4.00~~ 5.00								1		12'-6" X									X		
SB	1.341	G	UNK.	UNK.	UNK.		NO PARKING						1		X													
		G	R8-3a	24	24 ~~30~~			~~4.00~~ 5.00								1		12'-6" ~~X~~									X		
SB	1.334	E/F	D3-1	UNK.	UNK.		SPRING ST				1	1	1		X												SPRING ST (TH-365); SALVAGE AND MOUNT TO YIELD SIGN POST WITH BRACKET			
		H	R1-2	36	36		YIELD						1															
		G	VD-700	6	10		MILE MARKER				1	1	1														SPRING ST (TH-365); SALVAGE AND MOUNT ON NEW POST BELOW YIELD SIGN			
		H	R1-2	36	36			~~9.00~~ 3.90								1		13'-3" X								SPRING ST (TH-365); REQUIRES VEGETATION CLEARING	X		
SB	1.291	F	D3-1	UNK.	UNK.		SUMMER ST				~~1~~	~~1~~	1		X	~~1~~		~~X~~								SALVAGE AND MOUNT ON NEW POST			
							SHEET TOTALS	27.37 SF	0.00 SF	0 EA	3 EA	3 EA	9 EA	0 EA	0 EA	6 EA		90.0 FT		0 EA	0.0 LB	0.0 LB	0.0 LB	0.0 LB				
							TOWN DIRECTIONAL TOTALS	301.8 SF	0.0 SF	8 EA	11 EA	11 EA	75 EA	0 EA	0 EA	52 EA		780.0 FT		2 EA	270.0 LB							

8/16/16

SIGN SUMMARY SHEET

VERMONT AGENCY OF TRANSPORTATION

PROJECT NAME: **CALAIS - GREENSBORO**
PROJECT NUMBER: **STPG SIGN (50)**
FILE NAME: **06 HARDWICK VT-14 SB TSS.**
PROJECT MANAGER: **D. BRYANT**
DESIGNED BY: **J. BLANCHARD**
PLOT DATE: **5/19/2015**
DRAWN BY: **J. BLANCHARD**
CHECKED **K. KERN**
HARDWICK SB SHEET 8
SHEET **58** OF **66**