

CONSTRUCT GRAVEL DRIVE

VT 25B STA 11+38.1 RT
TH 51 STA 21+15.9 LT
TH 51 STA 21+28.5 RT

CONSTRUCT 4' PAVED APRON

VT 25B STA 11+06.8 LT - VT 25B STA 11+72.7 LT
TH 51 STA 20+95.3 LT - TH 51 STA 21+35.7 LT
TH 51 STA 21+04.7 RT - TH 51 STA 21+52.8 RT

CONSTRUCT 5' PAVED APRON

VT 25B STA 11+04.2 RT - VT 25B STA 11+87.5 RT

BRIDGE RAILING, GALVANIZED 3 RAIL BOX BEAM


VT 25B STA 13+80.3 LT - VT 25B STA 15+28.4 LT
VT 25B STA 13+98.9 RT - VT 25B STA 15+44.0 RT

RELOCATE MAILBOX, SINGLE SUPPORT

FROM VT 25B STA 11+60.9 RT TO VT 25B STA 11+60.9 RT
FROM VT 25B STA 11+62.9 RT TO VT 25B STA 11+62.9 RT

BOX BEAM GUARDRAIL

VT 25B STA 11+94.1 LT - VT 25B STA 13+48.1 LT
TH 51 STA 20+79.0 LT - VT 25B STA 13+67.1 RT
VT 25B STA 15+60.6 LT - VT 25B STA 15+86.8 LT
VT 25B STA 15+76.2 RT - VT 25B STA 16+00.0 RT

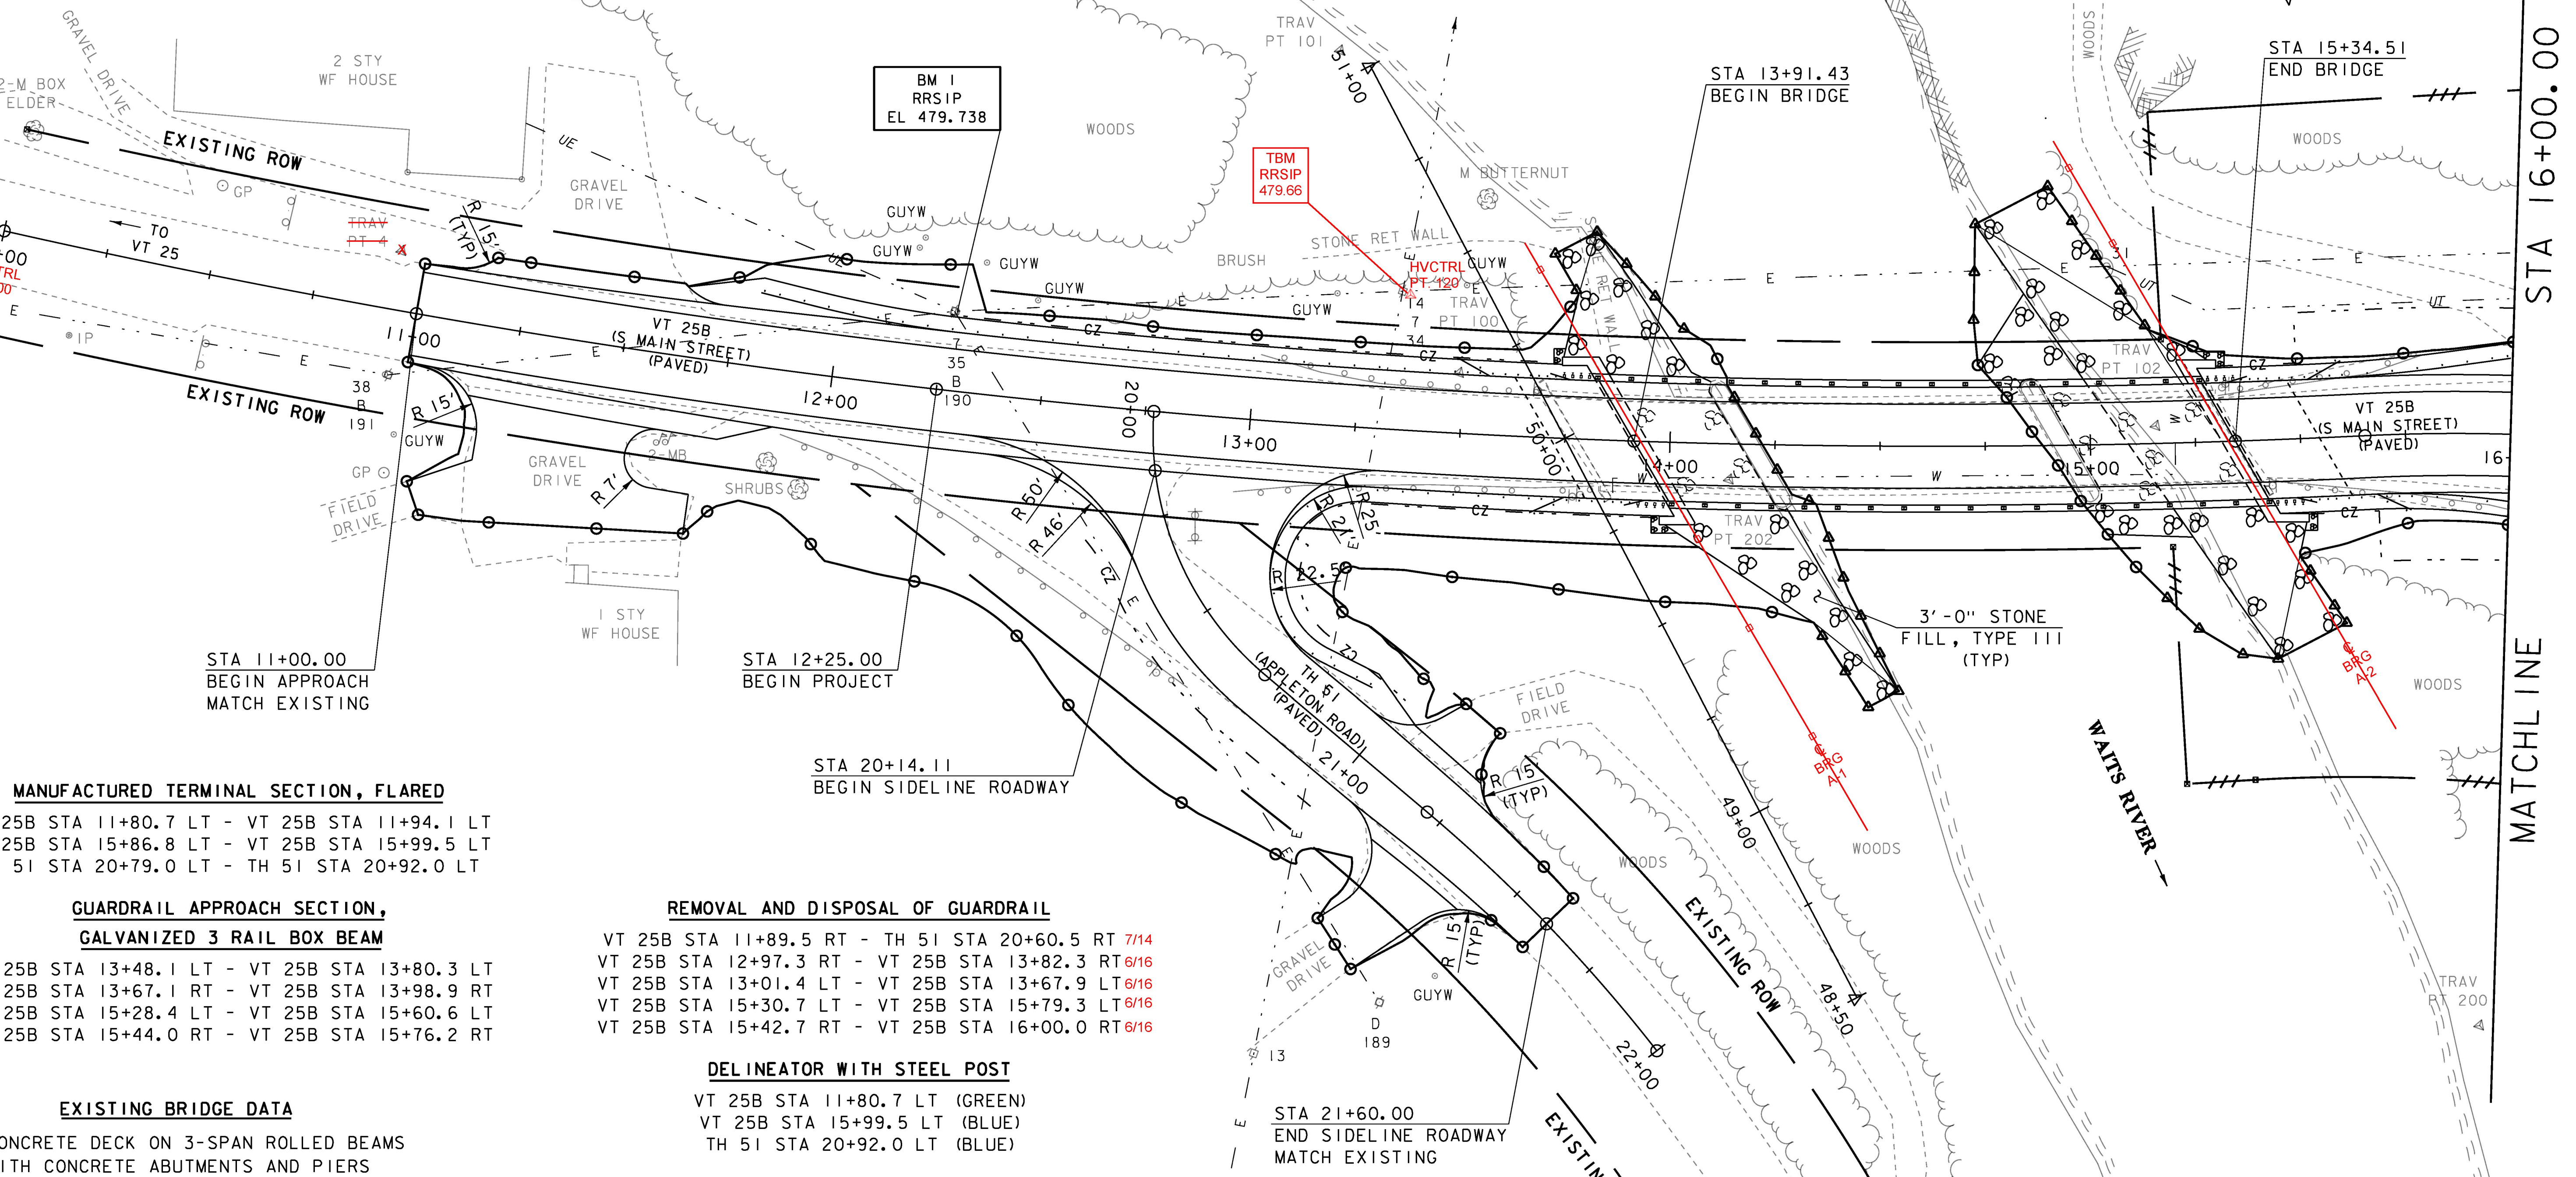

MANUFACTURED TERMINAL SECTION, FLARED

VT 25B STA 11+80.7 LT - VT 25B STA 11+94.1 LT
VT 25B STA 15+86.8 LT - VT 25B STA 15+99.5 LT
TH 51 STA 20+79.0 LT - TH 51 STA 20+92.0 LT

GUARDRAIL APPROACH SECTION,

GALVANIZED 3 RAIL BOX BEAM

VT 25B STA 13+48.1 LT - VT 25B STA 13+80.3 LT
VT 25B STA 13+67.1 RT - VT 25B STA 13+98.9 RT
VT 25B STA 15+28.4 LT - VT 25B STA 15+60.6 LT
VT 25B STA 15+44.0 RT - VT 25B STA 15+76.2 RT

EXISTING BRIDGE DATA

CONCRETE DECK ON 3-SPAN ROLLED BEAMS
WITH CONCRETE ABUTMENTS AND PIERS
BUILT 1933
OVERALL LENGTH: 160'
SPAN 1: 43'; SPAN 2: 74'; SPAN 3: 43'
FASCIA TO FASCIA WIDTH: 23.3'
ROADWAY WIDTH: 24'

REMOVAL AND DISPOSAL OF GUARDRAIL

VT 25B STA 11+89.5 RT - TH 51 STA 20+60.5 RT 7/14
VT 25B STA 12+97.3 RT - VT 25B STA 13+82.3 RT 6/16
VT 25B STA 13+01.4 LT - VT 25B STA 13+67.9 LT 6/16
VT 25B STA 15+30.7 LT - VT 25B STA 15+79.3 LT 6/16
VT 25B STA 15+42.7 RT - VT 25B STA 16+00.0 RT 6/16

DELINEATOR WITH STEEL POST

VT 25B STA 11+80.7 LT (GREEN)
VT 25B STA 15+99.5 LT (BLUE)
TH 51 STA 20+92.0 LT (BLUE)

PROJECT NAME:	BRADFORD	PLOT DATE:	15-SEP-2016
PROJECT NUMBER:	BF 0191 (29)	DRAWN BY:	G. ROY
FILE NAME:	sl3c054bdr.dgn	CHECKED BY:	M. EVANS-MONGEON
PROJECT LEADER:	C. CARLSON	LAYOUT (1)	SHEET 14 OF 71
DESIGNED BY:	G. ROY		

SCALE: 1" = 20'-0"