ABM INFO		SHIP	BILL OF MATERIAL					JOB NO.	DRAWING NO.	REV.
								706-1	7	
PAGE	LINE	MARK	QTY	MARK	MATERIAL	LENGTH FT	LENGTH INCHES	REMARKS	WT	PROCUREMENT NOTES
					DIAPHRAGMS					
3	H	7D1	47		W 27x84	5	0 1/2		424	

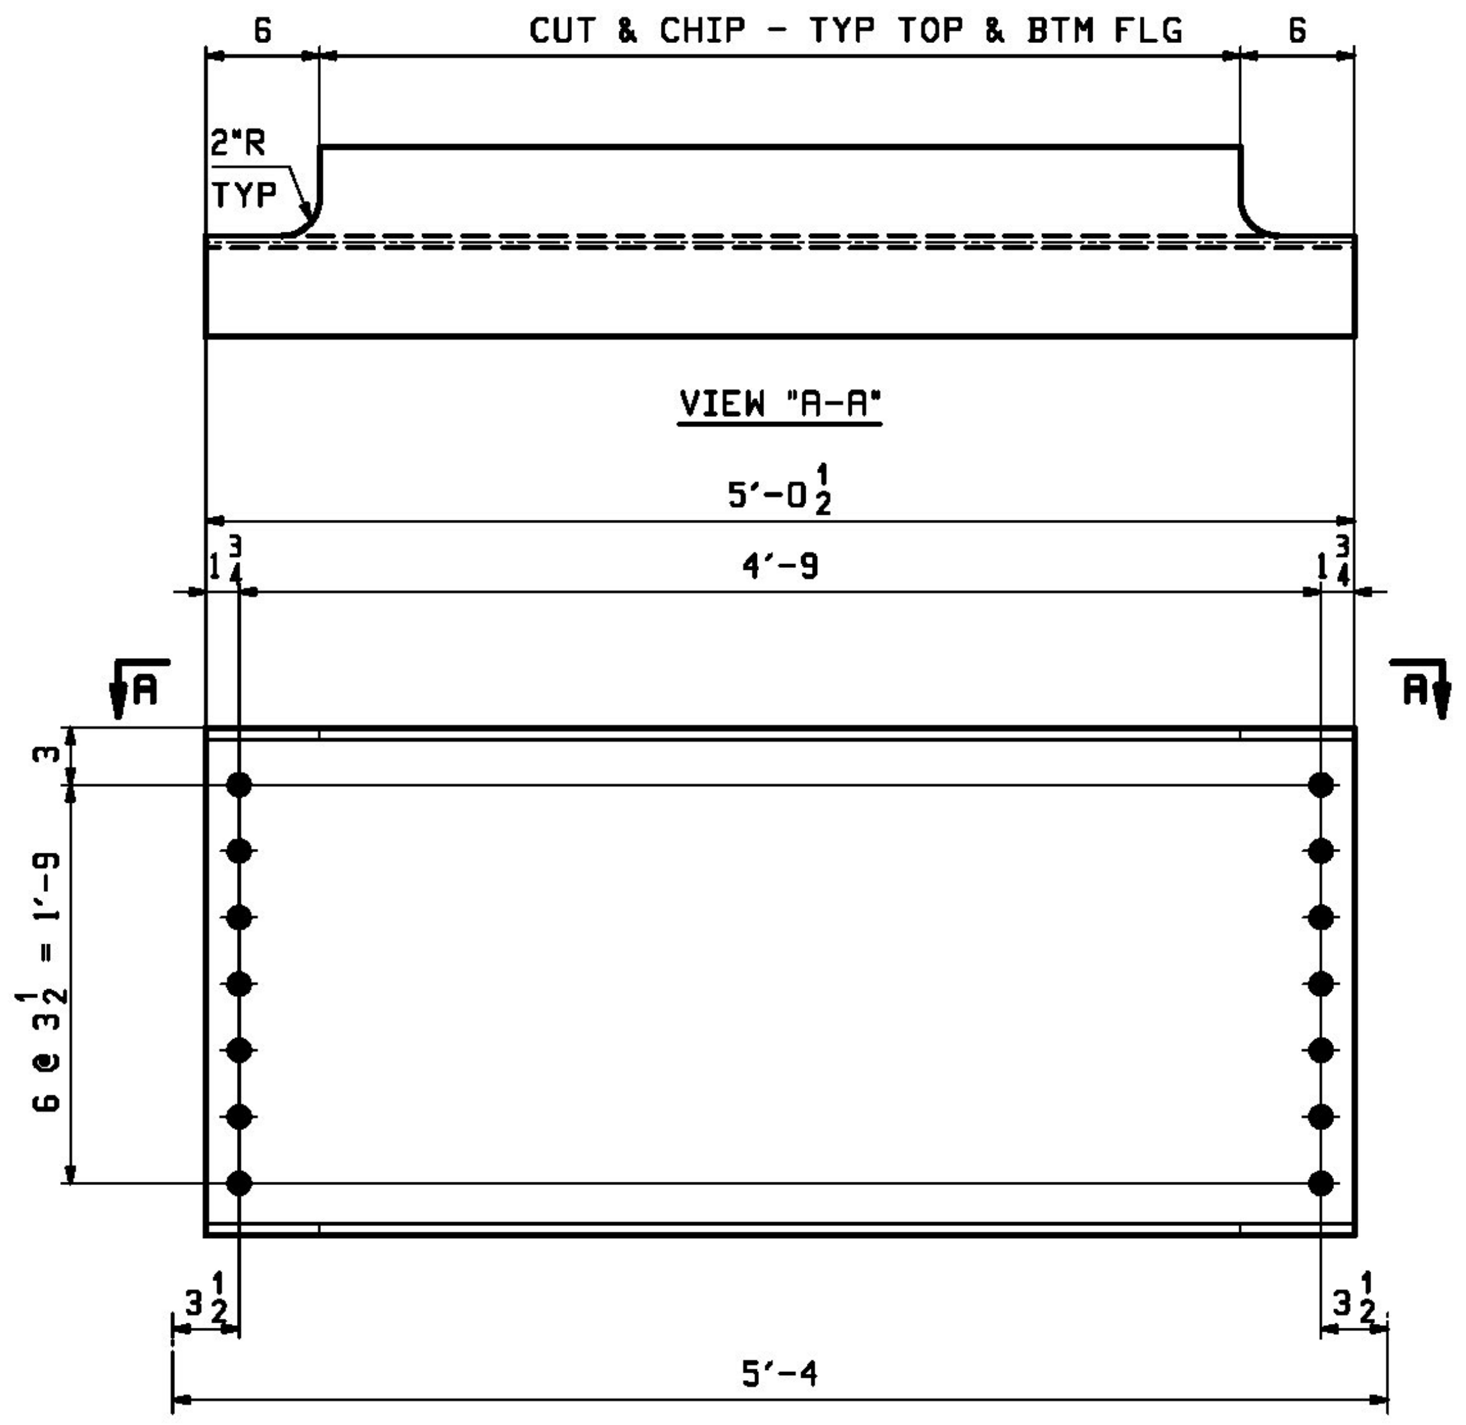

47 ~ INT. DIAPHRAGMS - 7D1

(LOOKING UP-STATION)

NOTE:
FOR GENERAL NOTES SEE DRAWING GN1.

0		∼				
REV.	DATE	REMARKS	DWN	CHK	APVL	SHOP

MATERIAL: M270-50	SURFACE PREP. & PAINT: SEE DWG GN1	HOLES: 15/16"ø	SHOP BOLTS: NONE

DESCRIPTION: DIAPHRAGMS

CASCO BAY STEEL STRUCTURES, INC.
1 WALLACE AVE.
SOUTH PORTLAND, ME 04106
PHONE (207) 780-6722
FAX. (207) 780-6726
TENSOR
3463

STRUCTURE:	ROUTE VT 25B OVER WAITS RIVER RURAL MAJOR COLLECTOR BRIDGE NO. 1 BRADFORD COUNTY OF ORANGE	DRAWN: JTB	DATE: 02/28
		CHKD: DBH	DATE: 03/13
LOCATION:	TOWN OF BRADFORD, VERMONT	JOB NO.	DWG NO.
PROJ NO.	BF 0191(29)	706-1	7
CUSTOMER:	A.L.ST. ONGE		REV. △

Vermont Agency of Transportation
RECEIVED
706_for_app_REV_1_05-07-2017_Approved 05-09-2017.pdf
CK'D BY ________ OK'D BY GFR
May 7, 2017
RESUBMIT No Approved
BY C. Carlson DATE 05/09/2017

JTB Mon, Mar 13, 2017 06:11:24 PM /users/jobs/3463/7 : Rev0