Record Plans
Contractor: PIKE INDUSTRIES, INC.
Resident Engineer: RYAN DARLING
Construction Began: APRIL 24, 2017
Construction Complete: DECEMBER 15, 2017
Record Plans By: RYAN DARLING & JESSE IVES

I hereby certify that all construction required by this set of drawings has been accomplished as indicated herein.

BY: e-Signed by Ryan Darling on 2018-06-11 17:50:27 GMT Resident Engineer

Date: June 11, 2018

NOTE: Any further information concerning final quantities, amounts or other details relative to this project may be found at Central Files in the electronic archives.

# STATE OF VERMONT
# AGENCY OF TRANSPORTATION




## PROPOSED IMPROVEMENT
## TOWNS OF ROCHESTER AND CHITTENDEN
## COUNTIES OF WINDSOR AND RUTLAND
## VT. ROUTE 73 (MAJOR COLLECTOR)

BEGINNING AT A POINT IN THE TOWN OF ROCHESTER ON VT. ROUTE 73 AT MILE MARKER 0.000 = STA R 0+00.00 AT THE TOWN LINE OF GOSHEN AND ROCHESTER AND EXTENDING EASTERLY FOR A DISTANCE OF APPROXIMATELY 25,217.87 FEET (4.776 MILES) TO THE TOWN LINE OF ROCHESTER AND CHITTENDEN. CONTINUING EASTERLY ALONG VT. ROUTE 73 IN THE TOWN OF CHITTENDEN FROM MILE MARKER 0.000 = STA C 0+00.00 FOR A DISTANCE OF APPROXIMATELY 704.54 FEET (0.133 MILE) TO THE TOWN LINE OF CHITTENDEN AND ROCHESTER AT MILE MARKER 0.133 = STA C 7+04.54. CONTINUING EASTERLY ALONG VT. ROUTE 73 IN THE TOWN OF ROCHESTER FROM MILE MARKER 4.776 = STA R 252+17.87 FOR A DISTANCE OF APPROXIMATLEY 20,859.81 FEET (3.951 MILES) TO AN ENDING POINT IN THE TOWN OF ROCHESTER AT MILE MARKER 8.727 = STA R 460+77.68.

| | | |
|---|---|---|
| LENGTH OF ROADWAY, TOWN OF ROCHESTER: | 46,077.68 FT | (8.727 MILES) |
| LENGHT OF ROADWAY, TOWN OF CHITTENDEN: | 704.54 FT | (0.133 MILE) |
| LENGTH OF PROJECT: | 46,782.22 FT | (8.860 MILES) |

WORK TO BE PERFORMED UNDER THIS PROJECT INCLUDES RECLAIMING AND/OR COLD PLANING SEGMENTS OF THE EXISTING HIGHWAY AND OVERLAYING WITH A LEVELING COURSE AND A WEARING COURSE, WITH PAVEMENT MARKINGS, GUARDRAIL, DRAINAGE IMPROVEMENTS AND OTHER HIGHWAY RELATED ITEMS.

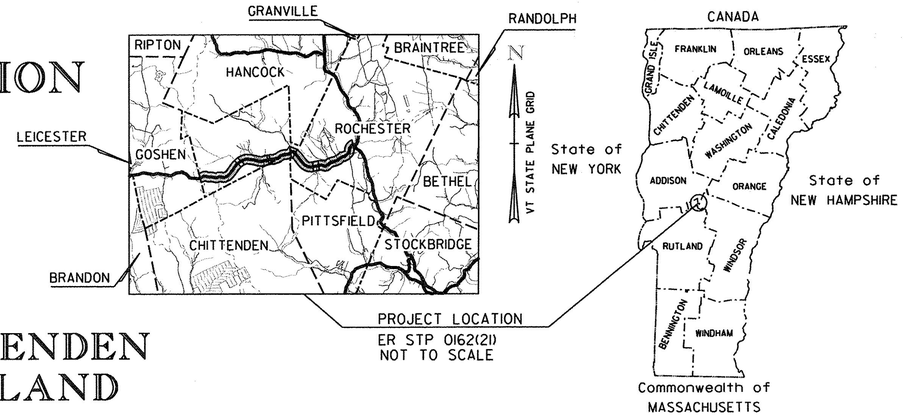


| LEGEND |
|---|
| ROCHESTER = STA R |
| CHITTENDEN = STA C |

CONSTRUCTION IS TO BE CARRIED ON IN ACCORDANCE WITH THESE PLANS AND THE STANDARD SPECIFICATIONS FOR CONSTRUCTION DATED 2011, AS APPROVED BY THE FEDERAL HIGHWAY ADMINISTRATION ON JULY 20, 2011 FOR USE ON THIS PROJECT, INCLUDING ALL SUBSEQUENT REVISIONS AND SUCH REVISED SPECIFICATIONS AND SPECIAL PROVISIONS AS ARE INCORPORATED IN THESE PLANS.

| | |
|---|---|
| QUALITY ASSURANCE PROGRAM : LEVEL 2 | |
| SURVEYED BY : | VERMONT SURVEY AND ENGINEERING, INC. |
| SURVEYED DATE : | JANUARY 2013 |
| DATUM | |
| VERTICAL | NAVD 88 FT |
| HORIZONTAL | NAD 83(2011) SFT |

0 6,000 12,000
SCALE IN FEET

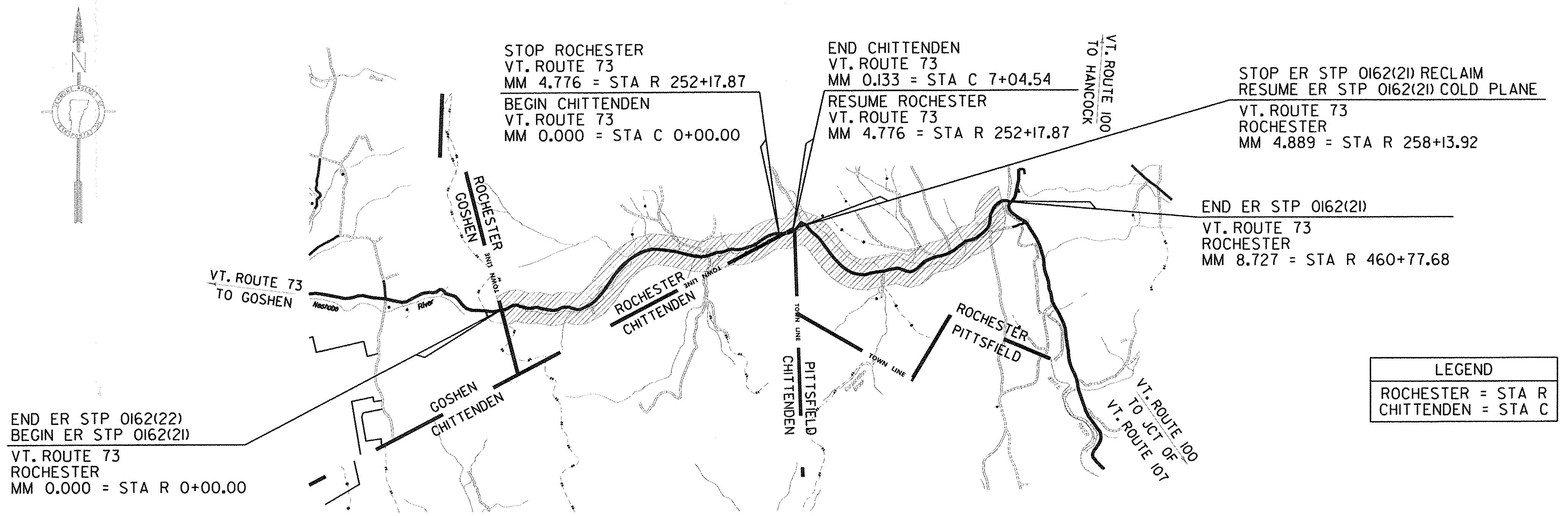PLANS PREPARED BY

STATE OF VERMONT ROBERT J. FAULKNER No. 7323 REGISTERED PROFESSIONAL ENGINEER
1/11/17

CHA

DIRECTOR OF PROJECT DELIVERY
APPROVED _____ DATE 1/12/2017

PROJECT MANAGER : MICHAEL J. FOWLER, P.E.

PROJECT NAME : ROCHESTER
PROJECT NUMBER : ER STP 0162(21)

SHEET 1 OF 360 SHEETS