DURABLE 4 INCH WHITE LINE (OPTION ITEM)
AND TEMPORARY 4 INCH WHITE LINE, PAINT
(ALL LINES WILL INCLUDE EDGE LINE BREAKS AND RADIUS FOR TOWN HIGHWAYS)
ROCHESTER:
STA R 218+00.00 - STA R 224+00.00 LT & RT

DURABLE 4 INCH YELLOW LINE, (OPTION ITEM) AND
TEMPORARY 4 INCH YELLOW LINE, PAINT
(ALL LINES WILL INCLUDE C/L BREAKS FOR TOWN HIGHWAYS) S = SOLID, D = DASHED
ROCHESTER:

	LT	℄	RT
STA R 218+00.00 - STA R 221+23.00	D	-	S
STA R 221+23.00 - STA R 224+00.00	S	-	S

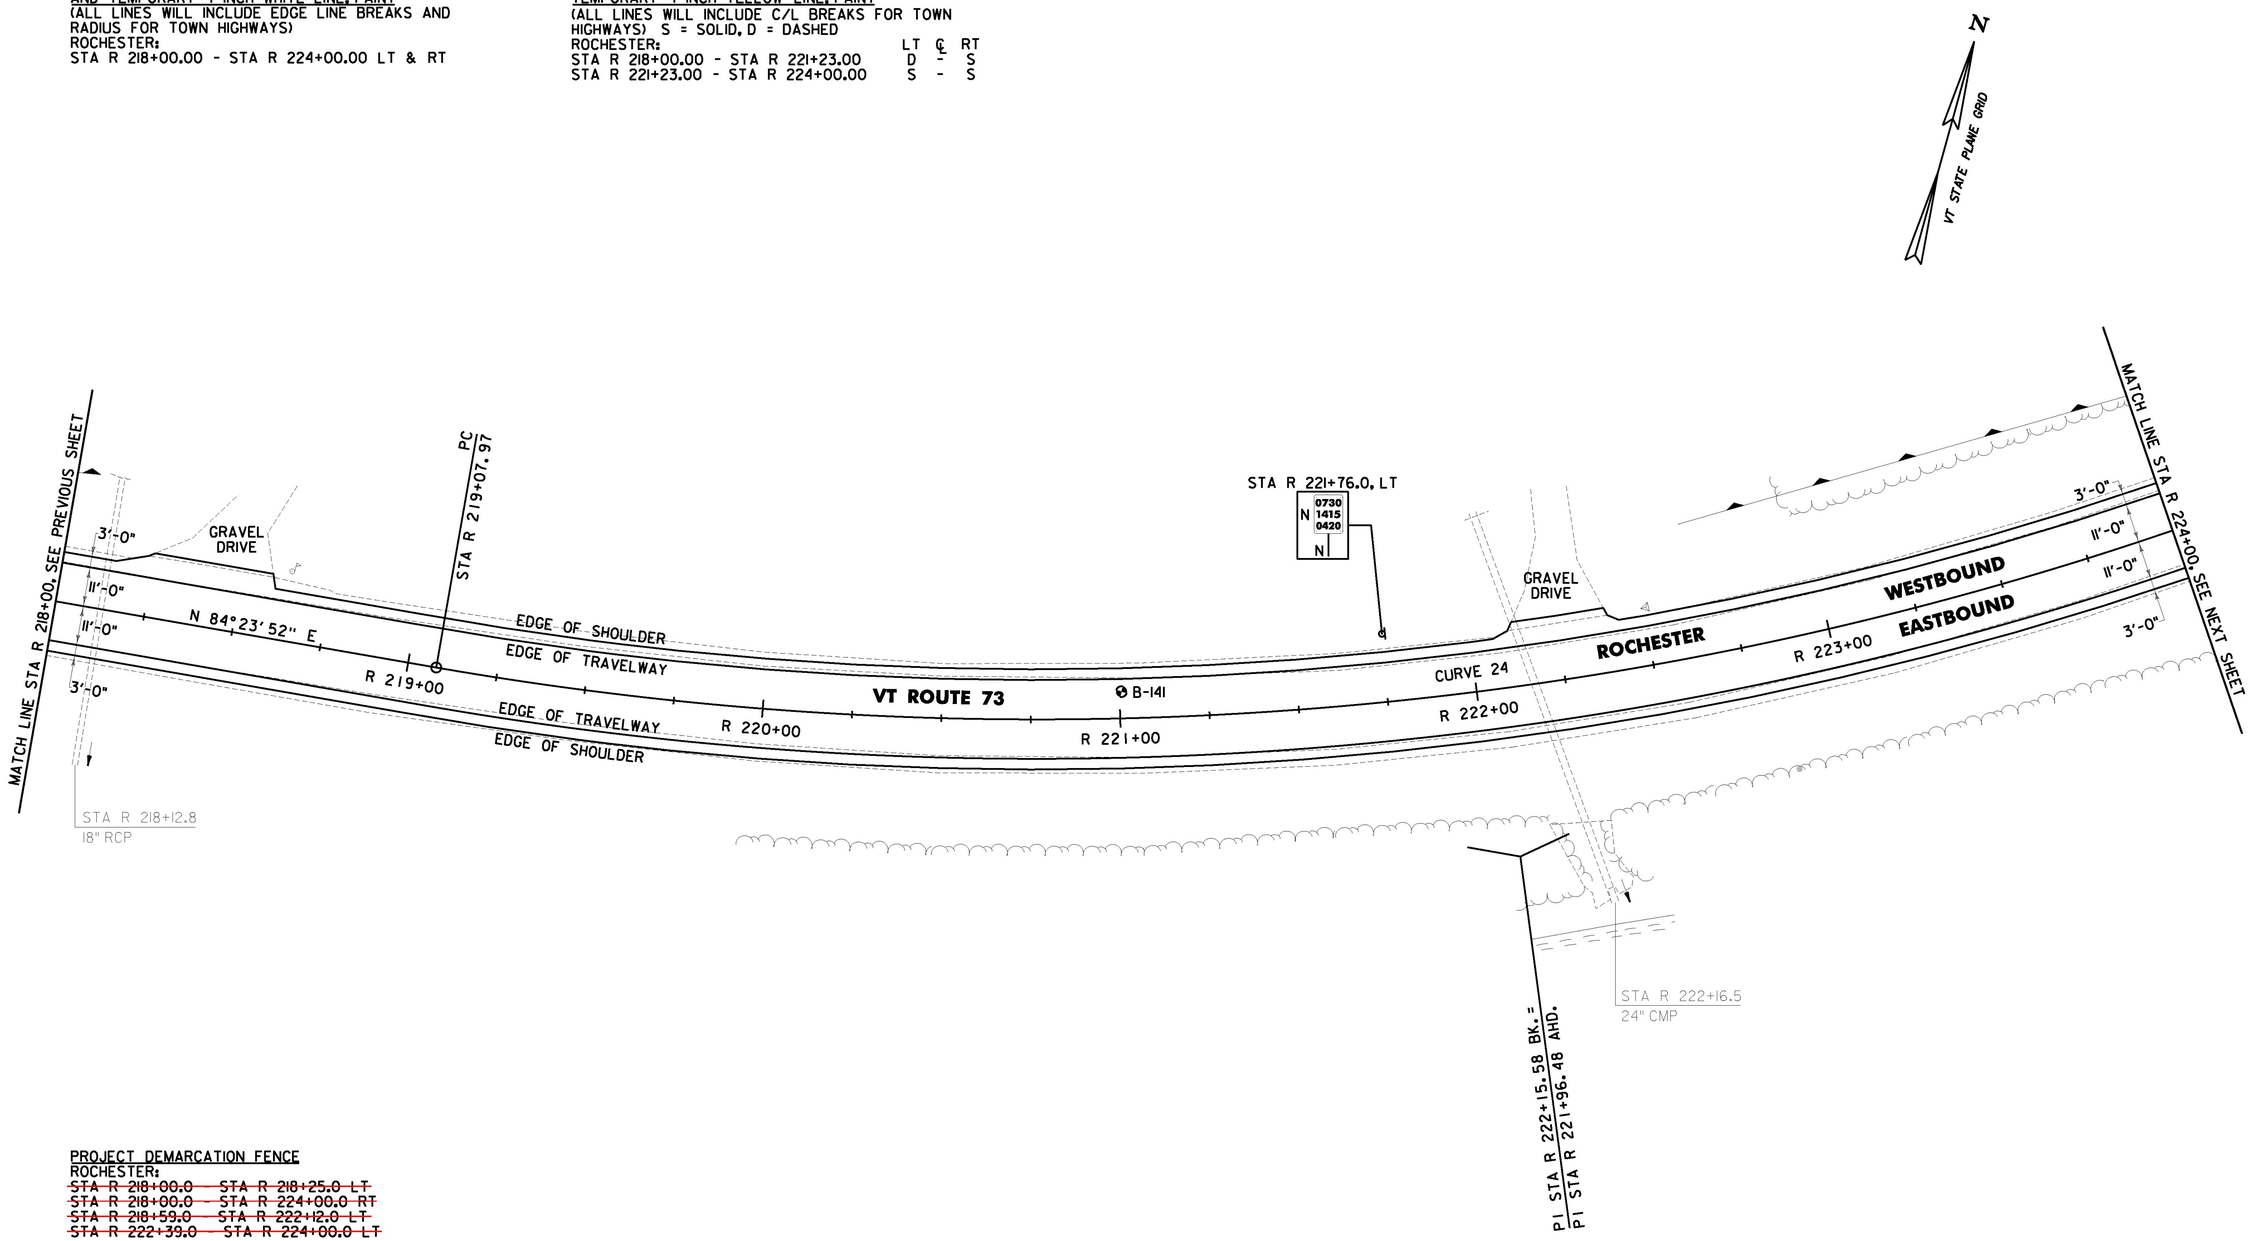

PROJECT DEMARCATION FENCE
ROCHESTER:
~~STA R 218+00.0 - STA R 218+25.0 LT~~
~~STA R 218+00.0 - STA R 224+00.0 RT~~
~~STA R 218+59.0 - STA R 222+12.0 LT~~
~~STA R 222+39.0 - STA R 224+00.0 LT~~

BARRIER FENCE
ROCHESTER:
~~STA R 218+00.0 - STA R 218+25.0 LT~~
~~STA R 218+59.0 - STA R 219+06.0 LT~~
~~STA R 221+61.0 - STA R 222+12.0 LT~~
~~STA R 222+39.0 - STA R 224+00.0 LT~~

SOIL BORING DATA			
BORING #	DEPTH (FT.)	PCC	COMMENTS
B-141	3.5	NO	REFUSAL AT 3.5'

CURVE 24
△ = 34°51'09" LT
D = 5°50'47"
R = 980.00'
T = 307.61'
L = 596.12'
E = 47.14'
e = 0.076 FT/FT

SIGN LEGEND
R = REMOVE
S = SALVAGE
N = NEW
RET = RETAIN
B-B = BACK TO BACK
EXISTING = ——————
NEW = ————————
R = RETURN TO TOWN OF ROCHESTER

0 20 40
SCALE IN FEET

CHA

PROJECT NAME: ROCHESTER
PROJECT NUMBER: ER STP 0162(21)

FILE NAME: z13c176bdr.dgn
PROJECT LEADER: D. GOZALKOWSKI
DESIGNED BY: J. OLSEN
PROJECT LAYOUT SHEET #38
PLOT DATE: 1/11/2017
DRAWN BY: J. HEALD
CHECKED BY: J. SHIELDS
SHEET 70 OF 360