DURABLE 4 INCH WHITE LINE (OPTION ITEM) AND TEMPORARY 4 INCH WHITE LINE, PAINT
(ALL LINES WILL INCLUDE EDGE LINE BREAKS AND RADIUS FOR TOWN HIGHWAYS)
ROCHESTER:
STA R 336+00.00 - STA R 342+00.00 LT & RT
STA R 340+92.96 EDGE LINES RT, TH-40

DURABLE 4 INCH YELLOW LINE, (OPTION ITEM) AND TEMPORARY 4 INCH YELLOW LINE, PAINT
(ALL LINES WILL INCLUDE C/L BREAKS FOR TOWN HIGHWAYS) S = SOLID, D = DASHED
ROCHESTER:
STA R 336+00.00 - STA R 342+00.00 LT S ℄ S RT
STA R 340+92.96 DOUBLE SOLID RT, TH-40

DURABLE 24 INCH STOP BAR, (OPTION ITEM) AND TEMPORARY 24 INCH STOP BAR, PAINT
ROCHESTER:
STA R 340+92.96 RT, TH-40

DURABLE LETTER OR SYMBOL, (OPTION ITEM)
ROCHESTER:
STA R 340+92.96 RT, TH-40, "S,T,O,P" (4 EA)

TEMPORARY LETTER OR SYMBOL, PAINT
ROCHESTER:
STA R 340+92.96 RT, TH-40, "S,T,O,P" (8 EA)

REMOVING SIGNS
AS SHOWN - 7

ERECTING SALVAGED SIGNS
AS SHOWN - 1

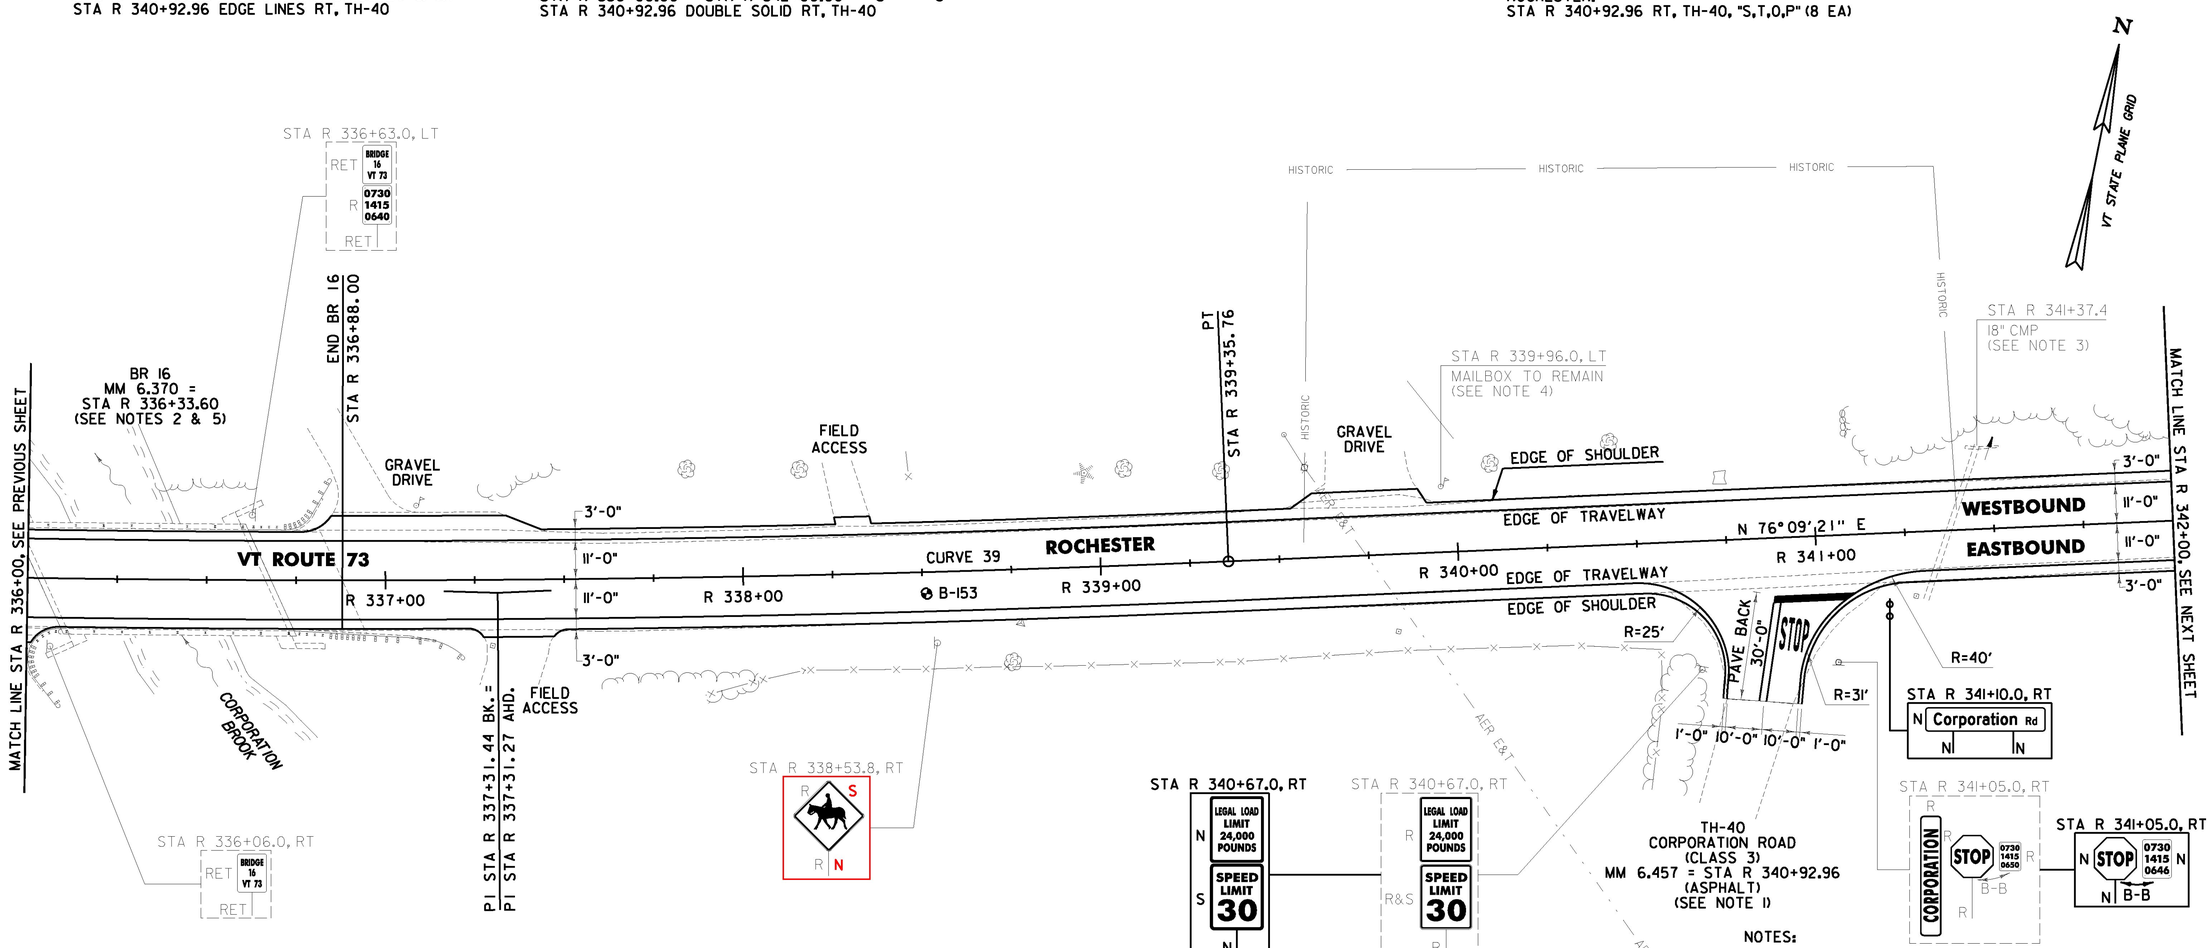

NOTES:

1. PAVING LIMIT ON ALL TOWN HIGHWAYS SHALL BE MEASURED 25 FT BACK FROM VT. ROUTE 73 EDGE OF SHOULDER UNLESS DENOTED OTHERWISE ON THE PLANS OR AS DIRECTED BY THE ENGINEER.
2. SEE SHEET 20 FOR COLD PLANE BRIDGE TRANSITION AREA DETAIL.
3. THE CONTRACTOR SHALL ADJUST THE PROPOSED SIDE SLOPE TO AVOID FILLING IN THE EXISTING PIPE AS DIRECTED BY THE ENGINEER.
4. THE CONTRACTOR SHALL ADJUST THE PROPOSED SIDE SLOPE TO AVOID FILLING IN THE EXISTING MAILBOX AS DIRECTED BY THE ENGINEER.
5. SEE STRUCTURES DETAIL SHEET SD-516.10 FOR DETAILS FOR ITEM 516.10 BRIDGE EXPANSION JOINT, ASPHALTIC PLUG, TO BE INSTALLED AT STA R 336+88.00

PROJECT DEMARCATION FENCE
ROCHESTER:
~~STA R 336+00.0 - STA R 336+87.0 LT~~
~~STA R 336+00.0 - STA R 337+28.0 RT~~
~~STA R 337+00.0 - STA R 338+26.0 LT~~
~~STA R 337+45.0 - STA R 340+72.0 RT~~
~~STA R 338+35.0 - STA R 339+60.0 LT~~
~~STA R 339+89.0 - STA R 342+00.0 LT~~
~~STA R 340+94.0 - STA R 342+00.0 RT~~

BARRIER FENCE
ROCHESTER:
~~STA R 338+57.0 - STA R 339+60.0 LT~~
~~STA R 339+89.0 - STA R 342+00.0 LT~~

SOIL BORING DATA			
BORING #	DEPTH (FT.)	PCC	COMMENTS
B-153	5.0	NO	

CURVE 39
Δ = 4° 05' 17" LT
D = 1° 00' 00"
R = 5729.58'
T = 204.49'
L = 408.81'
E = 3.65'
e = 0.022 FT/FT

SIGN LEGEND
R = REMOVE
S = SALVAGE
N = NEW
RET = RETAIN
B-B = BACK TO BACK
EXISTING = ------
NEW = ———
R = RETURN TO TOWN OF ROCHESTER

0 20 40
SCALE IN FEET

CHA

PROJECT NAME: ROCHESTER
PROJECT NUMBER: ER STP 0162(21)

FILE NAME: z13c176bdr.dgn
PROJECT LEADER: D. GOZALKOWSKI
DESIGNED BY: J. OLSEN
PROJECT LAYOUT SHEET #59
PLOT DATE: 1/11/2017
DRAWN BY: J. HEALD
CHECKED BY: J. SHIELDS
SHEET 91 OF 360