DURABLE 4 INCH WHITE LINE (OPTION ITEM) AND TEMPORARY 4 INCH WHITE LINE, PAINT
(ALL LINES WILL INCLUDE EDGE LINE BREAKS AND RADIUS FOR TOWN HIGHWAYS)
ROCHESTER:
STA R 378+00.00 - STA R 384+00.00 LT & RT

DURABLE 4 INCH YELLOW LINE, (OPTION ITEM) AND TEMPORARY 4 INCH YELLOW LINE, PAINT
(ALL LINES WILL INCLUDE C/L BREAKS FOR TOWN HIGHWAYS) S = SOLID, D = DASHED
ROCHESTER:

	LT	℄	RT
STA R 378+00.00 - STA R 381+48.00	D	-	S
STA R 381+48.00 - STA R 384+00.00	S	-	S

REMOVING SIGNS
AS SHOWN - 3

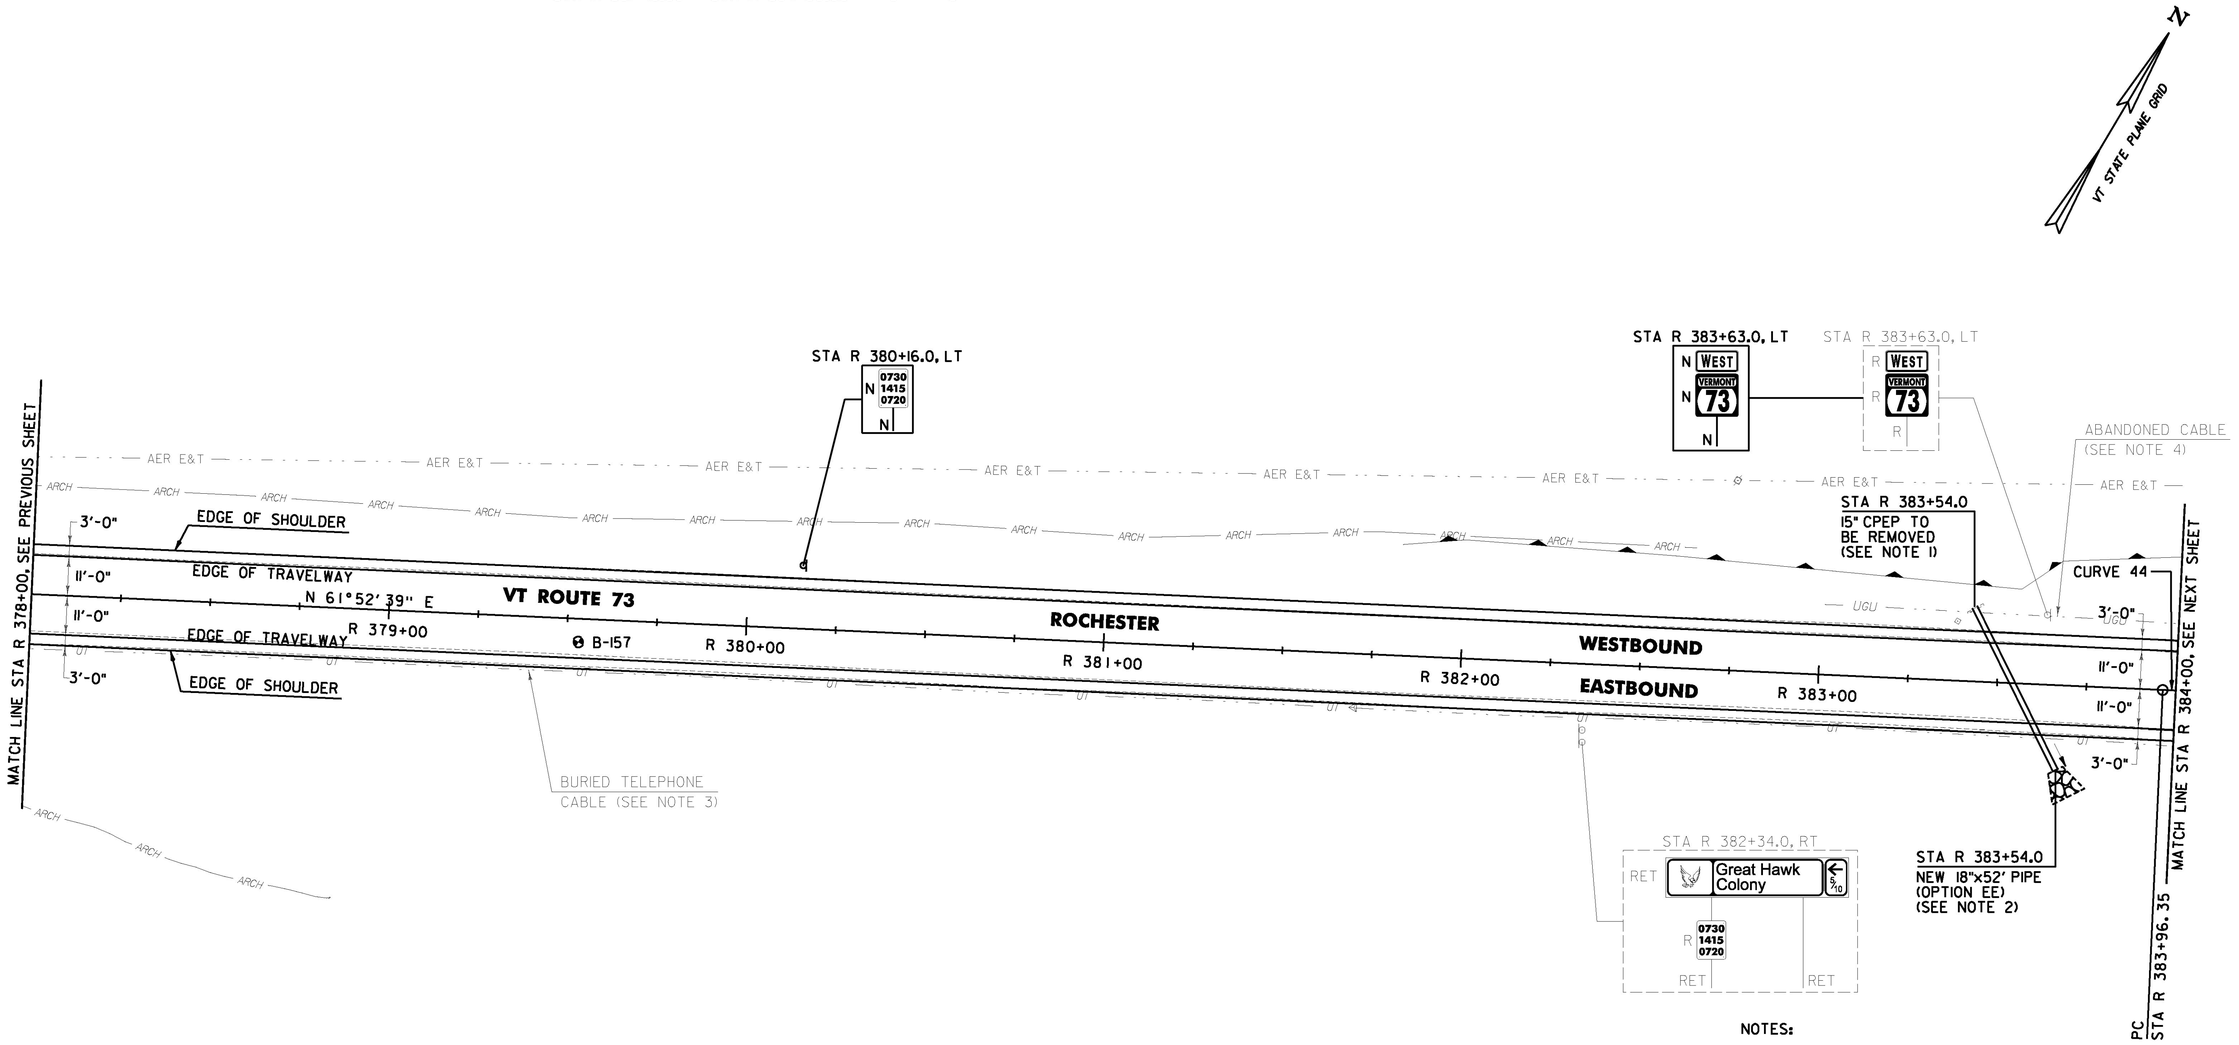

NOTES:

1. THE CONTRACTOR SHALL PERFORM ALL EXCAVATION REQUIRED TO REMOVE THE EXISTING PIPE AND INSTALL THE PROPOSED PIPE UNDER ITEM 204.20 TRENCH EXCAVATION OF EARTH AS DIRECTED BY THE ENGINEER.
2. SEE SHEET 24 FOR CULVERT ROADWAY CROSSING DETAIL.
3. THE CONTRACTOR SHALL CALL DIG SAFE AT 811 TO VERIFY LOCATION OF BURIED TELEPHONE CABLE.
4. THE CONTRACTOR SHALL CALL DIG SAFE AT 811 TO VERIFY LOCATION OF BURIED ABANDONED CABLE.

PROJECT DEMARCATION FENCE
ROCHESTER:
~~STA R 378+00.0 - STA R 384+00.0 LT & RT~~

BARRIER FENCE
ROCHESTER:
~~STA R 378+00.0 - STA R 379+92.0 RT~~
~~STA R 378+00.0 - STA R 384+00.0 LT~~

STONE FILL, TYPE II
ROCHESTER:
STA R 384+54.0, RT

SOIL BORING DATA			
BORING #	DEPTH (FT.)	PCC	COMMENTS
B-157	5.0	NO	

CURVE 44
△ = 11°24' 27" RT
D = 5° 12' 31"
R = 1100.00'
T = 109.87'
L = 219.01'
E = 5.47'
e = 0.058 FT/FT

LEGEND
ITEM 613.11
STONE FILL, TYPE II

SIGN LEGEND
R = REMOVE
S = SALVAGE
N = NEW
RET = RETAIN
B-B = BACK TO BACK
EXISTING = ------
NEW = ——————
R = RETURN TO TOWN OF ROCHESTER (1)

0 20 40
SCALE IN FEET

CHA

PROJECT NAME: ROCHESTER
PROJECT NUMBER: ER STP 0162(21)

FILE NAME: z13c176bdr.dgn
PROJECT LEADER: D. GOZALKOWSKI
DESIGNED BY: J. OLSEN
PROJECT LAYOUT SHEET #66
PLOT DATE: 1/11/2017
DRAWN BY: J. HEALD
CHECKED BY: J. SHIELDS
SHEET 98 OF 360