STONE FILL TYPE I, GEOTEXTILE UNDER STONE FILL & GRUBBING MATERIAL
~~STA. 0+36 TO 0+84, RT~~
~~STA. 1+08 TO 1+28, RT~~
STA. 3+00 TO 5+00, LT

DURABLE 4 INCH WHITE LINE, THERMOPLASTIC
DURABLE 4 INCH WHITE LINE, POLYUREA
TEMPORARY 4 INCH WHITE LINE, PAINT
BRAINTREE STA. 378+00 TO 378+97.72, SOLID LT & RT
GRANVILLE STA. 0+00 TO 5+00, SOLID LT & RT

DURABLE 4 INCH YELLOW LINE, THERMOPLASTIC
DURABLE 4 INCH YELLOW LINE, POLYUREA
TEMPORARY 4 INCH YELLOW LINE, PAINT
BRAINTREE STA. 378+00 TO 378+97.72, DASHED LT, SOLID RT
GRANVILLE STA. 0+00 TO 5+00, SOLID LT & RT

GEOTEXTILE FOR SILT FENCE
BRAINTREE STA. 378+00 TO 279+00, LT
BRAINTREE STA. 378+00 TO 378+98, RT
GRANVILLE STA. 0+00 TO 0+50, LT
GRANVILLE STA. 3+00 TO 5+00, LT

BARRIER FENCE
BRAINTREE STA. 378+00 TO 378+98, RT
GRANVILLE STA. 0+00 TO 5+00, RT

EROSION LOG
BRAINTREE STA. 378+00 TO 378+98, RT
BRAINTREE STA. 378+00 TO 378+97, LT
GRANVILLE STA. 0+00 TO 5+00, RT
GRANVILLE STA. 0+00 TO 3+50, LT

REMOVING SIGNS
AS SHOWN - 6

ERECTING SALVAGED SIGNS
AS SHOWN - 1

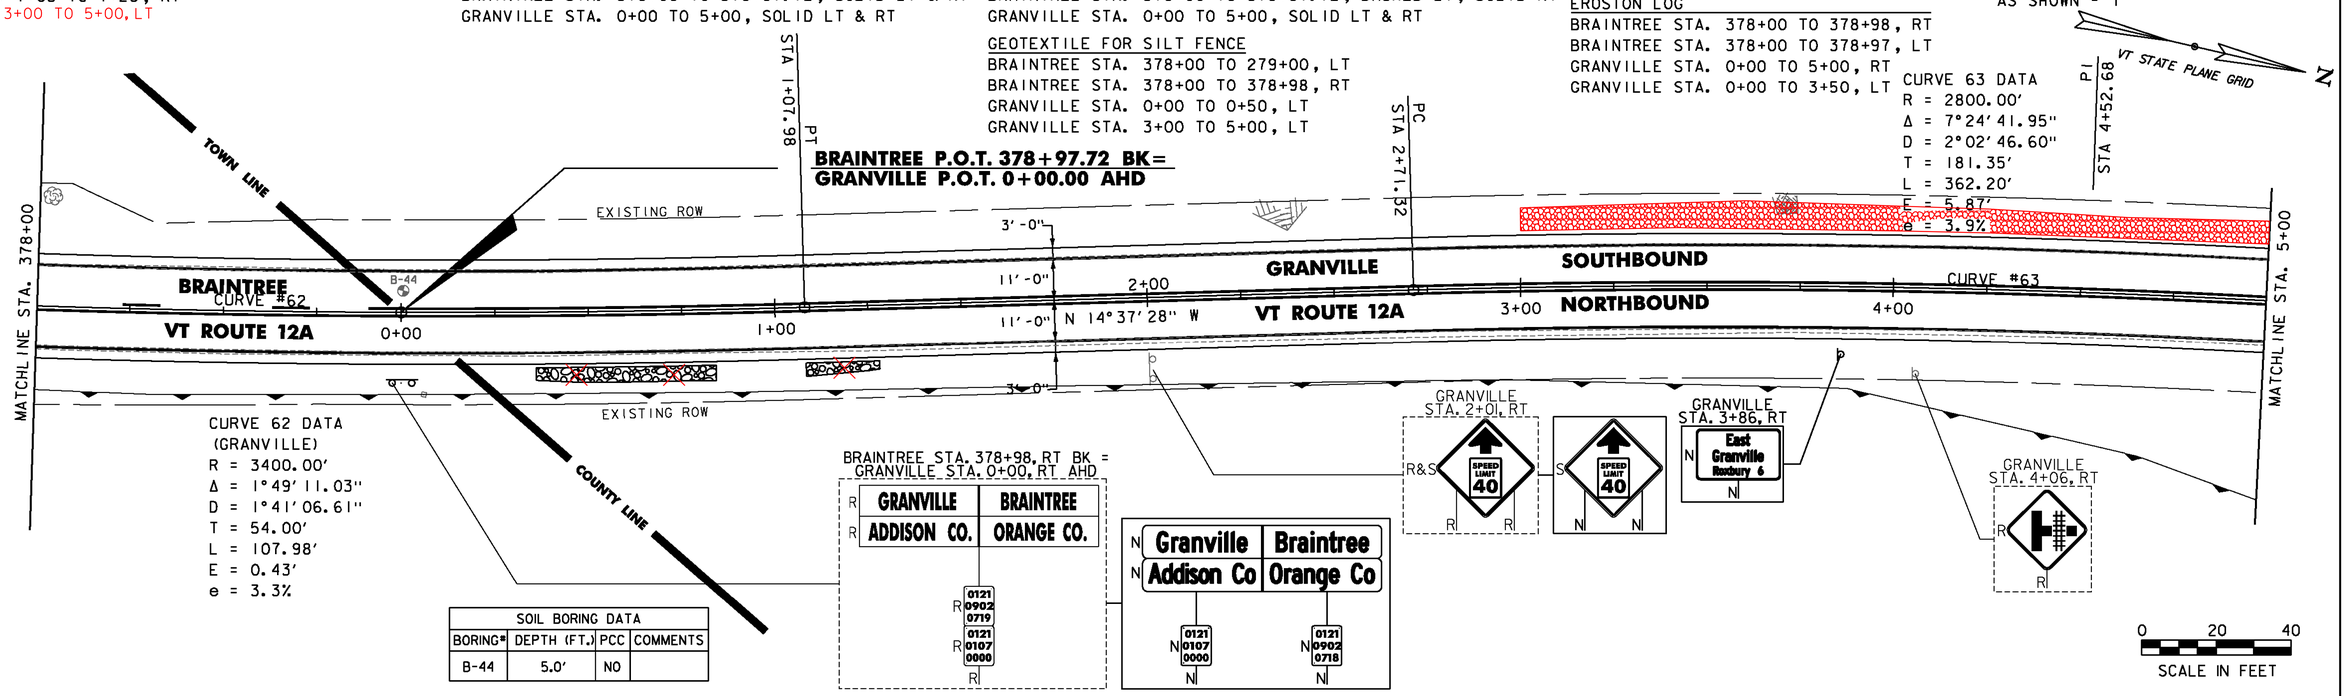

SOIL BORING DATA			
BORING#	DEPTH (FT.)	PCC	COMMENTS
B-44	5.0'	NO	

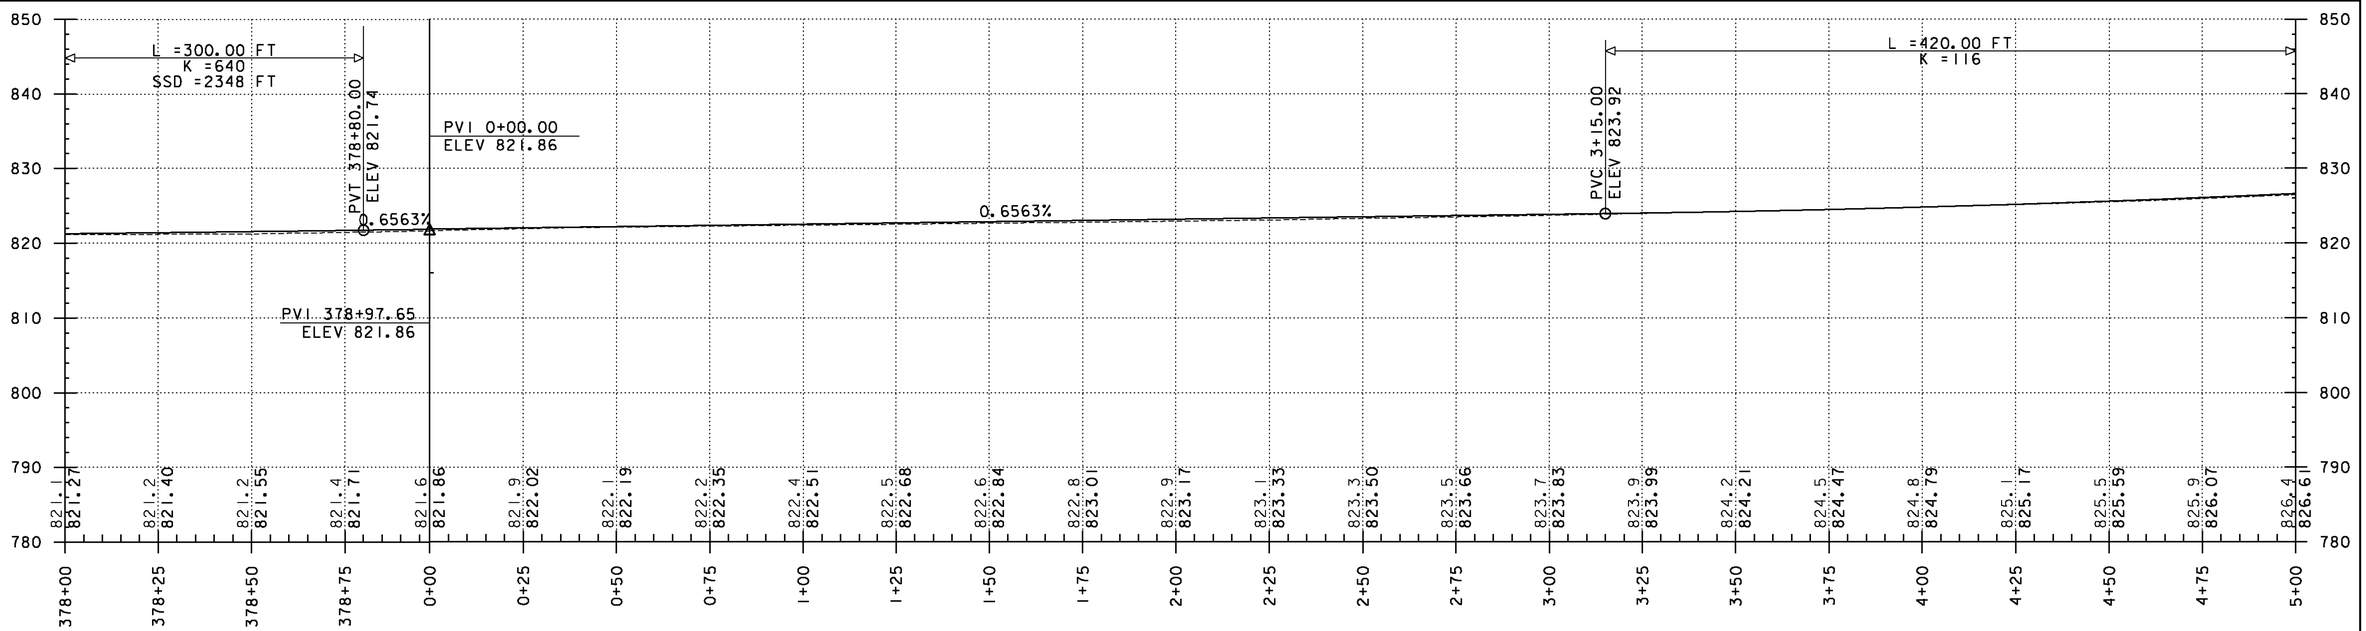

10 5 0 20 40
SCALE IN FEET

Stantec

PROJECT NAME: RANDOLPH-ROXBURY	
PROJECT NUMBER: ER STP 0187(11)	
FILE NAME: zl3cl82bdr.dgn	PLOT DATE: 11/17/2014
PROJECT LEADER: M. FOISY	DRAWN BY: G. BURGMEIER
DESIGNED BY: I. MAYNARD	CHECKED BY: M. FOISY
PLAN & PROFILE SHEET 85	SHEET 126 OF 545